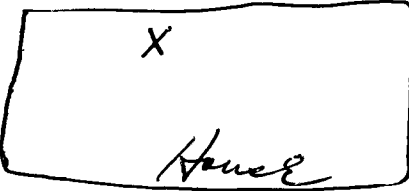


USE TYPEWRITER OR BALL
POINT PEN-PRESS FIRMLY,
PRINT CLEARLY.

WATER WELL RECORD
KSA 82a-1201-1215

Kansas Department of Health and
Environment-Division of Environment
(Water well Contractors)
Topeka, Kansas 66620

SE SW NW NW

1. Location of well: County <u>Sedgwick</u>		Fraction <u>NE 1/4 NW 1/4 NW 1/4</u>	Section number <u>18</u>	Township number <u>T 26 S</u>	Range number <u>R 1 E E</u>
2. Distance and direction from nearest town or city: Street address of well location if in city: <u>2319 W. 60th N.</u>			3. Owner of well: <u>RICHARD WEIR</u> R.R. or street: <u>2801 WOODLAND</u> City, state, zip code: <u>WICHITA, KS.</u>		
4. Locate with "X" in section below: N W E S 1 Mile 1 Mile		Sketch map: 		6. Bore hole dia. <u>4</u> in. Completion date <u>10-18-78</u> Well depth <u>27</u> ft.	
5. Type and color of material		From	To	7. <input type="checkbox"/> Cable tool <input type="checkbox"/> Rotary <input type="checkbox"/> Driven <input type="checkbox"/> Dug <input type="checkbox"/> Hollow rod <input checked="" type="checkbox"/> Jetted <input checked="" type="checkbox"/> Bored <input type="checkbox"/> Reverse rotary	
<u>Topsoil</u>		<u>0</u>	<u>10</u>	8. Use: <input checked="" type="checkbox"/> Domestic <input type="checkbox"/> Public supply <input type="checkbox"/> Industry <input type="checkbox"/> Irrigation <input type="checkbox"/> Air conditioning <input type="checkbox"/> Stock <input type="checkbox"/> Lawn <input type="checkbox"/> Oil field water <input type="checkbox"/> Other	
<u>Sand - Medium</u>		<u>11</u>	<u>19</u>	9. Casing: Material <u>PVC</u> Height: Above or below Threaded <input type="checkbox"/> Welded <input type="checkbox"/> Surface <u>12</u> in. RMP <input type="checkbox"/> PVC <input checked="" type="checkbox"/> Weight <u>2-750</u> lbs./ft. Dia. <u>5</u> in. to <u>22</u> ft. depth Wall Thickness: inches or Dia. <u>5</u> in. to <u>22</u> ft. depth gage No. <u>258</u>	
<u>Gravel - Coarse</u>		<u>20</u>	<u>27</u>	10. Screen: Manufacturer's name <u>Modern Pump Co.</u> Type <u>PVC</u> Dia. <u>5.563</u> Slot/gauze <u>.025</u> Length <u>10</u> Set between <u>20</u> ft. and <u>30</u> ft. ft. and ft. Gravel pack? <u>NO</u> Size range of material _____	
				11. Static water level: _____ mo./day/yr. <u>17</u> ft. below land surface Date <u>10-18-78</u>	
				12. Pumping level below land surfaces: <u>19</u> ft. after <u>1</u> hrs. pumping <u>80</u> g.p.m. ft. after _____ hrs. pumping _____ g.p.m. Estimated maximum yield <u>50</u> g.p.m.	
				13. Water sample submitted: _____ mo./day/yr. Yes <input type="checkbox"/> No <input checked="" type="checkbox"/> Date _____	
				14. Well head completion: Pitless adapter <u>12</u> inches above grade	
				15. Well grouted? <u>YES</u> With: <u>Neat cement</u> Bentonite _____ Concrete _____ Depth: From <u>0</u> ft. to <u>10</u> ft.	
				16. Nearest source of possible contamination: _____ ft. _____ Direction _____ Type <u>SEWER</u> Well disinfected upon completion? Yes <input checked="" type="checkbox"/> No <input type="checkbox"/>	
				17. Pump: <input checked="" type="checkbox"/> Not installed Manufacturer's name _____ Model number _____ HP _____ Volts _____ Length of drop pipe _____ ft. capacity _____ g.p.m. Type: <input type="checkbox"/> Submersible <input type="checkbox"/> Turbine <input type="checkbox"/> Jet <input type="checkbox"/> Reciprocating <input type="checkbox"/> Centrifugal <input type="checkbox"/> Other _____	
18. Elevation:		19. Remarks: <u>Finished Basement to be dug</u> <u>around well.</u>		20. Water well contractor's certification: This well was drilled under my jurisdiction and this report is true to the best of my knowledge and belief. <u>2157 Elatus No. 129</u> Business name <u>512 W. 21st</u> License No. <u>10-19-78</u> Address <u>J. Harris</u> Date <u>10-19-78</u> Signed _____ Authorized representative	

Forward the white, blue and pink copies to the Department of Health and Environment

Form WWC-5