


1 LOCATION OF WATER WELL:	Fraction	Section Number	Township Number	Range Number
County: Sedawick	NE ¼ NW ¼ SE ¼	11	T 26 S	R 1E E/W

2	WATER WELL OWNER:	Todd, Roger	
	RR#, St. Address, Box # :	402 Shawnee	Board of Agriculture, Division of Water Resources
	City, State, ZIP Code :	Kechi, Kansas	Application Number:

4. DEPTH OF COMPLETED WELL.....90..... ft. ELEVATION:

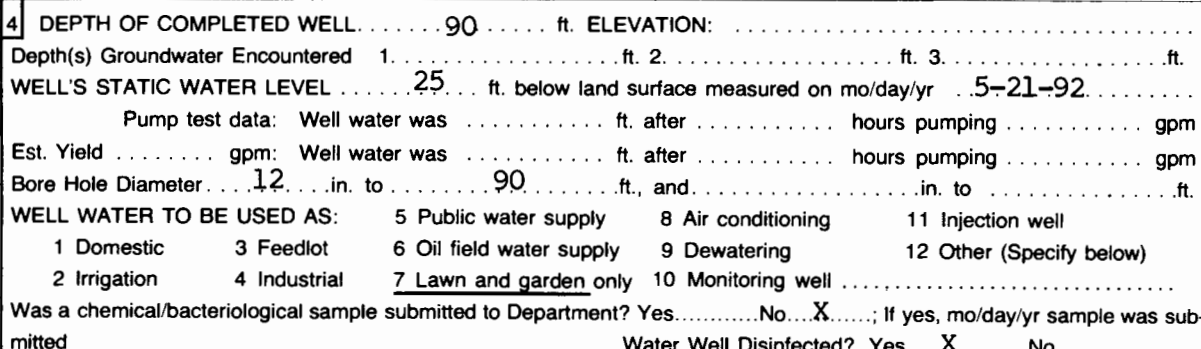

TYPE OF SCREEN OR PERFORATION MATERIAL:			7 PVC	10 Asbestos-cement
1 Steel	3 Stainless steel	5 Fiberglass	8 RMP (SR)	11 Other (specify)
2 Brass	4 Galvanized steel	6 Concrete tile	9 ABS	12 None used (open hole)
SCREEN OR PERFORATION OPENINGS ARE:			5 Gauzed wrapped	8 Saw cut
1 Continuous slot	3 Mill slot	6 Wire wrapped	9 Drilled holes	11 None (open hole)
2 Louvered shutter	4 Key punched	7 Torch cut	10 Other (specify)	

6 GROUT MATERIAL:		1 Neat cement	2 Cement grout	3 Bentonite	4 Other
Grout Intervals:	From	4	ft. to	24	ft.
What is the nearest source of possible contamination:					
1 Septic tank	4 Lateral lines	7 Pit privy	10 Livestock pens	14 Abandoned water well	
2 Sewer lines	5 Cess pool	8 Sewage lagoon	11 Fuel storage	15 Oil well/Gas well	
3 Watertight sewer lines	6 Seepage pit	9 Feedyard	12 Fertilizer storage	16 Other (specify below)	
			13 Insecticide storage		

[illegible]

7 CONTRACTOR'S OR LANDOWNER'S CERTIFICATION: This water well was (1) constructed, (2) reconstructed, or (3) plugged under my jurisdiction and was completed on (mo/day/year) 5-21-92 and this record is true to the best of my knowledge and belief. Kansas Water Well Contractor's License No. 236 This Water Well Record was completed on (mo/day/yr) 5-31-92 under the business name of Harp Well and Pump Service, Inc. by (signature) Mary Arnold

INSTRUCTIONS: Use typewriter or ball point pen. PLEASE PRESS FIRMLY and PRINT clearly. Please fill in blanks, underline or circle the correct answers. Send top three copies to Kansas Department of Health and Environment, Bureau of Water, Topeka, Kansas 66620-0001. Telephone: 913-296-5545. Send one to WATER WELL OWNER and retain one for your records.