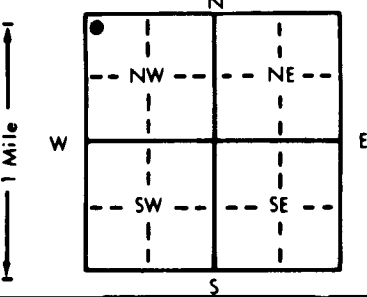


1 LOCATION OF WATER WELL: County: Sedgwick		Fraction NW 1/4 NW 1/4 NW 1/4	Section Number 16	Township Number T 26 S	Range Number R 1 EW
Distance and direction from nearest town or city street address of well if located within city? H & G Investments 6158 N Broadway, Wichita, KS.					
2 WATER WELL OWNER: Tom Harris RR#, St. Address, Box # : 6158 N Broadway City, State, ZIP Code : Wichita, KS. Board of Agriculture, Division of Water Resources Application Number:					
3 LOCATE WELL'S LOCATION WITH AN "X" IN SECTION BOX: 		4 DEPTH OF COMPLETED WELL: 25' 6" ft. ELEVATION: Depth(s) Groundwater Encountered 1. 16' ft. 2. ft. 3. ft. WELL'S STATIC WATER LEVEL 16.48 ft. below land surface measured on mo/day/yr 4-12-94 Pump test data: Well water was ft. after hours pumping gpm Est. Yield gpm: Well water was ft. after hours pumping gpm Bore Hole Diameter 8 1/2" in. to 25' 6" ft., and in. to ft. WELL WATER TO BE USED AS: 5 Public water supply 8 Air conditioning 11 Injection well 1 Domestic 3 Feedlot 6 Oil field water supply 9 Dewatering 12 Other (Specify below) 2 Irrigation 4 Industrial 7 Lawn and garden only 10 Monitoring well Was a chemical/bacteriological sample submitted to Department? Yes.....No X; If yes, mo/day/yr sample was submitted Water Well Disinfected? Yes No			
5 TYPE OF BLANK CASING USED: 1 Steel 3 RMP (SR) 5 Wrought iron 8 Concrete tile CASING JOINTS: Glued Clamped 2 PVC 4 ABS 6 Asbestos-Cement 9 Other (specify below) Welded Blank casing diameter 2.375 in. to 15' ft., Dia. in. to ft., Dia. in. to ft. Casing height above land surface Flush Mount in., weight lbs./ft. Wall thickness or gauge No. SDR-13 TYPE OF SCREEN OR PERFORATION MATERIAL: 1 Steel 3 Stainless steel 5 Fiberglass 8 RMP (SR) 10 Asbestos-cement Sch 40 2 Brass 4 Galvanized steel 6 Concrete tile 9 ABS 11 Other (specify) 12 None used (open hole) SCREEN OR PERFORATION OPENINGS ARE: 1 Continuous slot 3 Mill slot 5 Gauzed wrapped 8 Saw cut 11 None (open hole) 2 Louvered shutter 4 Key punched 6 Wire wrapped 9 Drilled holes 7 Torch cut 10 Other (specify) SCREEN-PERFORATED INTERVALS: From 25' ft. to 15' ft., From ft. to ft. From ft. to ft., From ft. to ft. GRAVEL PACK INTERVALS: From 25' 6" ft. to 13' ft., From ft. to ft. From ft. to ft., From ft. to ft.					
6 GROUT MATERIAL: 1 Neat cement 2 Cement grout 3 Bentonite 4 Other Grout Intervals: From 13' ft. to 4' ft., From 4' ft. to 0' ft., From ft. to ft. What is the nearest source of possible contamination: 1 Septic tank 4 Lateral lines 7 Pit privy 11 Fuel storage 14 Abandoned water well 2 Sewer lines 5 Cess pool 8 Sewage lagoon 12 Fertilizer storage 15 Oil well/Gas well 3 Watertight sewer lines 6 Seepage pit 9 Feedyard 13 Insecticide storage 16 Other (specify below) Direction from well? West How many feet? 100'					
FROM	TO	LITHOLOGIC LOG	FROM	TO	PLUGGING INTERVALS
0	1	Grass-Dk brn to blk silty soil, moist to wet, earthy odor.			
1	5	Dk brn to med brn tight silty clay, moist, slight mottling, earthy odor, iron staining.			
5	11.50	Grayish brn clayey silt, moist to wet at 10', soft, no odor.			
11.5	25.6	fine-med grained grayish sand, moist to wet, no odor, subrounded to rounded, well sorted. wet at 17' Sand-fine to coarse grained at 20'.			
7 CONTRACTOR'S OR LANDOWNER'S CERTIFICATION: This water well was (1) constructed (2) reconstructed, or (3) plugged under my jurisdiction and was completed on (mo/day/year) 4-12-94 and this record is true to the best of my knowledge and belief. Kansas Water Well Contractor's License No. 539 This Water Well Record was completed on (mo/day/yr) 4-23-94 under the business name of JB Environmental Drilling by (signature) James Becker					