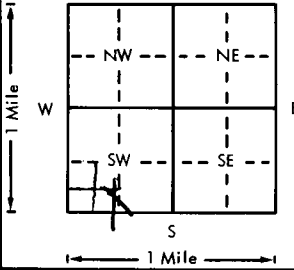
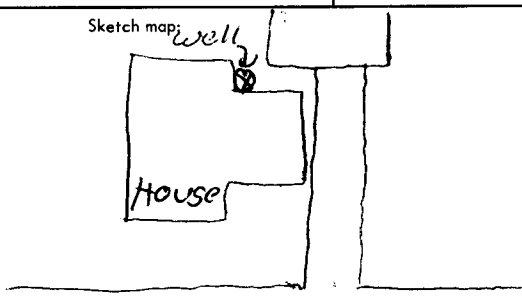


USE TYPEWRITER OR BALL
POINT PEN-PRESS FIRMLY,
PRINT CLEARLY.

WATER WELL RECORD
KSA 82a-1201-1215

Kansas Department of Health and
Environment-Division of Environment
(Water well Contractors)
Topeka, Kansas 66620

1. Location of well: County <u>Sedgwick</u>		Section <u>SE-SW-SW</u> SW-SW-SW 1/4		Section number <u>17</u>	Township number <u>26</u>	Range number <u>1</u> <u>EW</u>
2. Distance and direction from nearest town or city: <u>Wichita</u>		3. Owner of well: <u>ANTONIO GILBUENFI</u>				
Street address of well location if in city: <u>5411 N. ARMSTRONG</u>		R.R. or street: <u>5411 ARMSTRONG</u>				
City, state, zip code: <u>WICHITA, KS.</u>						
4. Locate with "X" in section below: 		Sketch map: 		6. Bore hole dia. <u>11</u> in. Completion date <u>7-28-78</u> Well depth <u>30</u> ft.		
5. Type and color of material		From	To	7. <input type="checkbox"/> Cable tool <input type="checkbox"/> Rotary <input type="checkbox"/> Driven <input type="checkbox"/> Dug <input type="checkbox"/> Hollow rod <input checked="" type="checkbox"/> Jetted <input checked="" type="checkbox"/> Bored <input type="checkbox"/> Reverse rotary		
<u>Topsoil</u>		<u>0</u>	<u>11</u>	8. Use: <input type="checkbox"/> Domestic <input type="checkbox"/> Public supply <input type="checkbox"/> Industry <input type="checkbox"/> Irrigation <input type="checkbox"/> Air conditioning <input type="checkbox"/> Stock <input checked="" type="checkbox"/> Lawn <input type="checkbox"/> Oil field water <input type="checkbox"/> Other		
<u>Sandy dirt</u>		<u>12</u>	<u>19</u>	9. Casing: Material <u>PVC</u> Height: Above or below Threaded <input type="checkbox"/> Welded <input type="checkbox"/> Surface <u>12</u> in. RMP <input type="checkbox"/> PVC <input checked="" type="checkbox"/> Weight <u>2.58</u> lbs./ft. Dia. <u>5</u> in. to <u>30</u> ft. depth Wall Thickness inches or Dia. <u>5</u> in. to <u>30</u> ft. depth gage No. <u>258</u>		
<u>Gravel</u>		<u>20</u>	<u>30</u>	10. Screens: Manufacturer's name <u>Modern</u> Type <u>PVC</u> Dia. <u>5.563</u> Slot/gauze <u>.025</u> Length <u>5</u> Set between <u>25</u> ft. and <u>30</u> ft. ft. and ft. Gravel pack? <u>NO</u> Size range of material		
				11. Static water level: mo./day/yr. <u>19</u> ft. below land surface Date <u>7-28-78</u>		
				12. Pumping level below land surfaces: <u>19</u> ft. after <u>1</u> hrs. pumping <u>20</u> g.p.m. ft. after hrs. pumping g.p.m. Estimated maximum yield <u>75</u> g.p.m.		
				13. Water sample submitted: mo./day/yr. Yes <input type="checkbox"/> No <input checked="" type="checkbox"/> Date		
				14. Well head completion: <input type="checkbox"/> Pitless adapter <u>12</u> Inches above grade		
				15. Well grouted? <u>Yes</u> With: <input checked="" type="checkbox"/> Neat cement <input type="checkbox"/> Bentonite <input type="checkbox"/> Concrete Depth: From <u>0</u> ft. to <u>10</u> ft.		
				16. Nearest source of possible contamination: ft. <u>65</u> Direction <u>E</u> Type <u>Sept</u> Well disinfected upon completion? Yes <input checked="" type="checkbox"/> No <input type="checkbox"/>		
				17. Pump: <input checked="" type="checkbox"/> Not installed Manufacturer's name Model number HP Volts Length of drop pipe ft. capacity g.p.m. Type: <input type="checkbox"/> Submersible <input type="checkbox"/> Turbine <input type="checkbox"/> Jet <input type="checkbox"/> Reciprocating <input type="checkbox"/> Centrifugal <input type="checkbox"/> Other		
(Use a second sheet if needed)						
18. Elevation: Topography: <input type="checkbox"/> Hill <input type="checkbox"/> Slope <input checked="" type="checkbox"/> Upland <input type="checkbox"/> Valley	19. Remarks:		20. Water well contractor's certification: This well was drilled under my jurisdiction and this report is true to the best of my knowledge and belief. <u>21st Electric Co. 129</u> Business name <u>512 W. 21ST</u> License No. Address <u>J. Harris</u> Date <u>8-12-78</u> Signed <u>J. Harris</u> Authorized representative			

Forward the white, blue and pink copies to the Department of Health and Environment

Form WWC-5