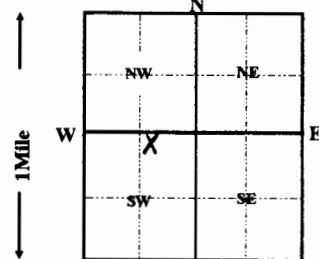


1 LOCATION OF WATER WELL: <b>Sedgwick</b>		FRACTION <b>NW 1/4 NE 1/4 SW 1/4</b>		Section Number <b>18</b>		Township Number <b>T 26 S</b>		Range Number <b>R 1E E/W</b>	
Distance and direction from nearest town or city street address of well if located within city? <b>5746 N. Charles Wichita, Kansas</b>									
2 WATER WELL OWNER: <b>BOBBITT, Bob</b>		Board of Agriculture, Division of Water Resource RR#, ST. ADDRESS, BOX #: <b>5746 N. Charles</b> CITY, STATE, ZIP CODE: <b>Wichita, Kansas</b> Application Number:							
3 LOCATE WELL'S LOCATION WITH AN "X" IN SECTION BOX: 		4 DEPTH OF COMPLETED WELL <b>29</b> ft. ELEVATION: <b>basement floor</b> Depth(s) groundwater Encountered <b>1</b> ft. <b>basement floor</b> ft. <b>3</b> ft. WELL'S STATIC WATER LEVEL <b>9.5</b> FT. BELOW LAND SURFACE MEASURED ON <b>07/30/1992</b> Pump test data: Well water was _____ ft. after _____ hours pumping _____ gpm Est. Yield _____ gpm: Well water was _____ ft. after _____ hours pumping _____ gpm Bore Hole Diameter _____ in. to _____ ft., and _____ in. to _____ ft. WELL WATER TO BE USED AS: <b>5</b> Public water supply <b>8</b> Air conditioning <b>11</b> Injection well <b>1</b> Domestic <b>3</b> Feedlot <b>6</b> Oil field water supply <b>9</b> dewatering <b>12</b> Other (Specify below) <b>2</b> Irrigation <b>4</b> Industrial <b>7</b> Lawn and garden only <b>10</b> Monitoring well Was a chemical/bacteriological sample submitted to Department? Yes _____ No _____ ; If yes, mo/day/yr sample was submitted _____ Water Well Disinfected? Yes <input checked="" type="checkbox"/> No _____							
5 TYPE OF CASING USED: 1 Steel <b>3 RMP (SR)</b> 5 Wrought iron 8 Concrete tile CASING JOINTS: Glued Clamped 2 PVC <b>4 ABS</b> 6 Asbestos-Cement 9 Other (Specify below) Welded Blank casing Diameter <b>5</b> in. to _____ ft., Dia _____ in. to _____ ft., Dia _____ in. to _____ ft. Casing height above land surface <b>2</b> ft. <b>X</b> weight _____ lbs. / ft. Wall thickness or gauge No. _____ TYPE OF SCREEN OR PERFORATION MATERIAL: 7 PVC 10 Asbestos-cement 1 Steel 3 Stainless Steel 5 Fiberglass 8 RMP (SR) 11 other (specify) _____ 2 Brass 4 Galvanized steel 6 Concrete tile 9 ABS 12 None used (open hole) _____ SCREEN OR PERFORATION OPENING ARE: 5 Gauzed wrapped 8 Saw cut 11 None (open hole) 1 Continuous slot 3 Mill slot 6 Wire wrapped 9 Drilled holes 2 Louvered shutter 4 Key punched 7 Torch cut 10 Other (specify) _____ SCREEN-PERFORATION INTERVALS: from _____ ft. to _____ ft., From _____ ft. to _____ ft. GRAVEL PACK INTERVALS: from _____ ft. to _____ ft., From _____ ft. to _____ ft.									
6 GROUT MATERIAL: 1 Neat cement 2 Cement grout 3 Bentonite 4 Other Grout Intervals: From <b>0</b> ft. to <b>5</b> ft., From _____ ft. to _____ ft., From _____ ft. to _____ ft. What is the nearest source of possible contamination: 10 Livestock pens 14 Abandon water well 1 Septic tank 4 Lateral lines 7 Pit privy 11 Fuel storage 15 Oil well/Gas well 2 Sewer lines 5 Cess pool 8 Sewage lagoon 12 Fertilizer storage 16 Other (specify below) _____ 3 Watertight sewer lines 6 Seepage pit 9 Feedyard 13 Insecticide storage Direction from well? <b>East</b> How many feet? <b>75</b>									
7 CONTRACTOR'S OR LANDOWNER'S CERTIFICATION: This water well was (1) constructed, (2) reconstructed, or (3) plugged under my jurisdiction and was completed on (mo/day/year) <b>07/30/1992</b> and this record is true to the best of my knowledge and belief. Kansas Water Well Contractor's License No. <b>236</b> This Water Well Record was completed on (mo/day/yr) <b>09/02/92</b> Under the business name of <b>Harp Well &amp; Pump Service, Inc.</b> by (signature) <i>Jane Frederick</i>									