

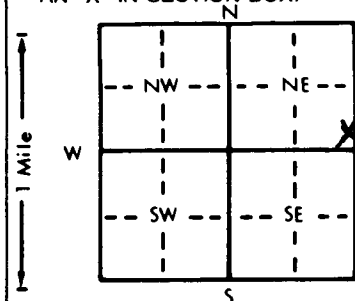
1 LOCATION OF WATER WELL:	Fraction	Section Number	Township Number	Range Number
County: <u>Sedgwick</u>	<u>SE</u> $\frac{1}{4}$ <u>SE</u> $\frac{1}{4}$ <u>NE</u> $\frac{1}{4}$	<u>18</u>	<u>T</u> <u>26</u> <u>S</u>	<u>R</u> <u>1E</u> <u>E/W</u>

Distance and direction from nearest town or city street address of well if located within city?

5849 Palm Lane Wichita, Kansas

2 WATER WELL OWNER: <u>Williams, Roy</u>	Board of Agriculture, Division of Water Resources
RR#, St. Address, Box # : <u>5849 Palm Lane</u>	Application Number:
City, State, ZIP Code : <u>Wichita, Kansas</u>	

3 LOCATE WELL'S LOCATION WITH AN "X" IN SECTION BOX:	4 DEPTH OF COMPLETED WELL: <u>40</u> ft. ELEVATION:
--	---


WELL WATER TO BE USED AS: 5 Public water supply 8 Air conditioning 11 Injection well

1 Domestic 3 Feedlot 6 Oil field water supply 9 Dewatering 12 Other (Specify below)

2 Irrigation 4 Industrial 7 Lawn and garden only 10 Monitoring well

Was a chemical/bacteriological sample submitted to Department? Yes X No X; If yes, mo/day/yr sample was submittedWater Well Disinfected? Yes X No X

5 TYPE OF BLANK CASING USED:	5 Wrought iron	8 Concrete tile	CASING JOINTS: Glued <u>X</u> Clamped
1 Steel	3 RMP (SR)	6 Asbestos-Cement	9 Other (specify below) <u>SDR-26</u>
2 PVC	4 ABS	7 Fiberglass	11 Injection well
			12 Other (Specify below)

Blank casing diameter 5 in. to 30 ft., Dia 30 in. to 30 ft., Dia 30 in. to 30 ft.Casing height above land surface 12 in., weight 2.29 lbs./ft. Wall thickness or gauge No. 214

TYPE OF SCREEN OR PERFORATION MATERIAL:	7 PVC	10 Asbestos-cement
1 Steel	3 Stainless steel	5 Fiberglass
2 Brass	4 Galvanized steel	6 Concrete tile
		8 RMP (SR)
		9 ABS
		11 Other (specify)
		12 None used (open hole)

SCREEN OR PERFORATION OPENINGS ARE: 5 Gauzed wrapped 8 Saw cut 11 None (open hole)

1 Continuous slot 3 Mill slot 6 Wire wrapped 9 Drilled holes

2 Louvered shutter 4 Key punched 7 Torch cut 10 Other (specify)


6 GROUT MATERIAL: 1 Neat cement 2 Cement grout 3 Bentonite 4 Other

Grout Intervals: From 4 ft. to 24 ft., From 4 ft. to 24 ft., From 4 ft. to 24 ft.

What is the nearest source of possible contamination: 10 Livestock pens 14 Abandoned water well

1 Septic tank 4 Lateral lines 7 Pit privy 11 Fuel storage 15 Oil well/Gas well

2 Sewer lines 5 Cess pool 8 Sewage lagoon 12 Fertilizer storage 16 Other (specify below)

3 Watertight sewer lines 6 Seepage pit 9 Feedyard 13 Insecticide storage

Direction from well? North How many feet? 75

FROM TO LITHOLOGIC LOG FROM TO PLUGGING INTERVALS

0 2 topsoil

2 15 clay

15 40 medium to coarse sand

INSTRUCTIONS: Use typewriter or ball point pen. PLEASE PRESS FIRMLY and PRINT clearly. Please fill in blanks, underline or circle the correct answers. Send top three copies to Kansas Department of Health and Environment, Bureau of Water, Topeka, Kansas 66620-0001. Telephone: 913-296-5545. Send one to WATER WELL OWNER and retain one for your records.

OFFICE USE ONLY

T

R

EW

SEC.

1/4

1/4

1/4