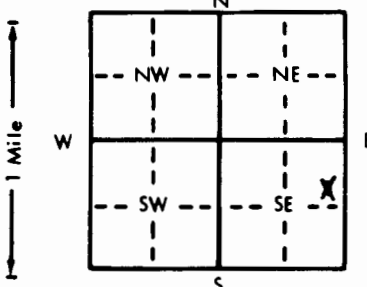


1 LOCATION OF WATER WELL:		Fraction	Section Number	Township Number	Range Number
County: <u>Sedgwick</u>		<u>SE</u> $\frac{1}{4}$ <u>NE</u> $\frac{1}{4}$ <u>SE</u> $\frac{1}{4}$	<u>18</u>	<u>T</u> <u>26</u> <u>S</u>	<u>R</u> <u>1E</u> <u>E/W</u>
Distance and direction from nearest town or city street address of well if located within city? <u>5640 N. Sullivan Wichita, Kansas</u>					
2 WATER WELL OWNER: <u>Bandhauer, Roy</u>					
RR#, St. Address, Box #: <u>5640 N. Sullivan</u>					
City, State, ZIP Code: <u>Wichita, Kansas 67204</u>					
Board of Agriculture, Division of Water Resources Application Number:					
3 LOCATE WELL'S LOCATION WITH AN "X" IN SECTION BOX:		4 DEPTH OF COMPLETED WELL: <u>45</u> ft. ELEVATION: <u>7-15-91</u>			

5 TYPE OF BLANK CASING USED:					
Direction from well? <u>East</u> How many feet? <u>90</u>					
FROM	TO	LITHOLOGIC LOG	FROM	TO	PLUGGING INTERVALS
0	3	topsoil			
3	9	clay			
9	18	fine sand			
18	45	medium to coarse sand			
7 CONTRACTOR'S OR LANDOWNER'S CERTIFICATION: This water well was (1) constructed, (2) reconstructed, or (3) plugged under my jurisdiction and was completed on (mo/day/year) <u>7-15-91</u> and this record is true to the best of my knowledge and belief. Kansas Water Well Contractor's License No. <u>236</u> This Water Well Record was completed on (mo/day/yr) <u>11-13-91</u> under the business name of <u>Harp Well and Pump Service, Inc.</u> by (signature) <u>Mary Arnold</u>					
INSTRUCTIONS: Use typewriter or ball point pen. PLEASE PRESS FIRMLY and PRINT clearly. Please fill in blanks, underline or circle the correct answers. Send two copies to Kansas Department of Health and Environment, Bureau of Water, Topeka, Kansas 66620-0001. Telephone: 913-296-5545. Send one to WATER WELL OWNER and retain one for your records.					