


1 LOCATION OF WATER WELL: Fraction SW 1/4 NE 1/4 SW 1/4 Section Number 18 Township Number T 26 S Range Number R 10 E
 County: Sedgwick
 Distance and direction from nearest town or city street address of well if located within city? See Below.

2 WATER WELL OWNER: STEVE CLARY
 RR#, St. Address, Box #: 5529 No athenian
 City, State, ZIP Code: WICHITA, KS 67204
 Board of Agriculture, Division of Water Resources Application Number:

3 LOCATE WELL'S LOCATION WITH AN "X" IN SECTION BOX: 4 DEPTH OF COMPLETED WELL: 144 ft. ELEVATION: 18 ft. below land surface measured on 9-28-88
 AN "X" IN SECTION BOX:

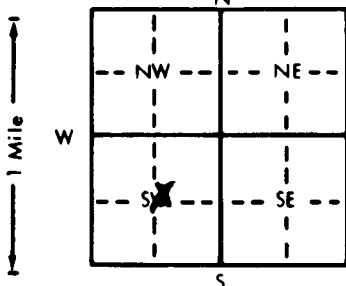

Depth(s) Groundwater Encountered 1. 18 ft. 2. 18 ft. 3. 18 ft.
 WELL'S STATIC WATER LEVEL 18 ft. below land surface measured on 9-28-88
 Pump test data: Well water was 18 ft. after 12 hours pumping 30 gpm
 Est. Yield 70 gpm: Well water was 18 ft. after 12 hours pumping 30 gpm
 WELL WATER TO BE USED AS:
☒ 1 Domestic ☐ 3 Feedlot ☐ 6 Oil field water supply ☐ 9 Dewatering ☐ 12 Other (Specify below)
☐ 2 Irrigation ☐ 4 Industrial ☐ 7 Lawn and garden only ☐ 10 Monitoring well
 Was a chemical/bacteriological sample submitted to Department? Yes X No X; If yes, mo/day/yr sample was submitted
 Water Well Disinfected? Yes X No X

5 TYPE OF BLANK CASING USED:
☐ 1 Steel ☒ 3 RMP (SR) ☐ 5 Wrought iron ☐ 8 Concrete tile CASING JOINTS: ☒ Glued ☐ Clamped
☐ 2 PVC ☐ 4 ABS ☐ 6 Asbestos-Cement ☐ 9 Other (specify below) ☐ Welded
☐ 7 Fiberglass ☐ Threaded


TYPE OF SCREEN OR PERFORATION MATERIAL:
☐ 1 Steel ☐ 3 Stainless steel ☐ 5 Fiberglass ☒ 8 RMP (SR) ☐ 10 Asbestos-cement
☐ 2 Brass ☐ 4 Galvanized steel ☐ 6 Concrete tile ☐ 9 ABS ☐ 11 Other (specify)
☐ 12 None used (open hole)

SCREEN OR PERFORATION OPENINGS ARE:
☐ 1 Continuous slot ☒ 8 Mill slot ☐ 5 Gauzed wrapped ☐ 8 Saw cut ☐ 11 None (open hole)
☐ 2 Louvered shutter ☐ 4 Key punched ☐ 6 Wire wrapped ☐ 9 Drilled holes
☐ 7 Torch cut ☐ 10 Other (specify)



What is the nearest source of possible contamination:
☒ 1 Septic tank ☐ 4 Lateral lines ☐ 7 Pit privy ☐ 10 Livestock pens ☐ 14 Abandoned water well
☐ 2 Sewer lines ☐ 5 Cess pool ☐ 8 Sewage lagoon ☐ 11 Fuel storage ☐ 15 Oil well/Gas well
☐ 3 Watertight sewer lines ☐ 6 Seepage pit ☐ 9 Feedyard ☐ 12 Fertilizer storage ☐ 16 Other (specify below)
☐ 13 Insecticide storage

Direction from well? South How many feet? 80

FROM	TO	LITHOLOGIC LOG	FROM	TO	PLUGGING INTERVALS
0	2	Top so.			
2	14	Clay			
14	29	fine sand			
29	30	clay			
30	44	gravel			

7 CONTRACTOR'S OR LANDOWNER'S CERTIFICATION: This water well was (1) constructed, (2) reconstructed, or (3) plugged under my jurisdiction and was completed on (mo/day/year) 9-28-88 and this record is true to the best of my knowledge and belief. Kansas Water Well Contractor's License No. 318 This Water Well Record was completed on (mo/day/year) 9-28-88 under the business name of Wenger Dilling by (signature) Wenger