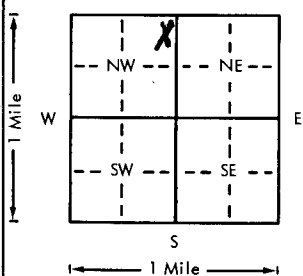


USE TYPEWRITER OR BALL
POINT PEN-PRESS FIRMLY,
PRINT CLEARLY.

WATER WELL RECORD
KSA 82a-1201-1215

Kansas Department of Health and
Environment-Division of Environment
(Water well Contractors)
Topeka, Kansas 66620

1. Location of well:		County SEDGWICK	Fraction NE 1/4 NE 1/4 NW 1/4	Section number 18	Township number T 26 S	Range number R 1E E/W
2. Distance and direction from nearest town or city: Street address of well location if in city: 1801 W. 60th No. Valley Center, Ks.				3. Owner of well: R. E. Muzzy Construction R.R. or street: 736 Butler City, state, zip code: Valley Center, Ks.		
4. Locate with "X" in section below: 				Sketch map:		
5. Type and color of material				6. Bore hole dia. 11 in. Completion date 3-16-79 Well depth 45 ft.		
				7. <input type="checkbox"/> Cable tool <input checked="" type="checkbox"/> Rotary <input type="checkbox"/> Driven <input type="checkbox"/> Dug <input type="checkbox"/> Hollow rod <input type="checkbox"/> Jetted <input type="checkbox"/> Bored <input type="checkbox"/> Reverse rotary		
				8. Use: <input checked="" type="checkbox"/> Domestic <input type="checkbox"/> Public supply <input type="checkbox"/> Industry <input type="checkbox"/> Irrigation <input type="checkbox"/> Air conditioning <input type="checkbox"/> Stock <input type="checkbox"/> Lawn <input type="checkbox"/> Oil field water <input type="checkbox"/> Other		
				9. Casing: Material styrene Height: Above or below 44 Threaded <input type="checkbox"/> Welded <input checked="" type="checkbox"/> Surface 12 in. RMP <input checked="" type="checkbox"/> PVC <input type="checkbox"/> Weight <input type="checkbox"/> lbs./ft. Dia. 5 in. to 45 ft. depth Wall Thickness: inches or Dia. <input type="checkbox"/> in. to <input type="checkbox"/> ft. depth gage No. 200		
				10. Screen: Manufacturer's name Sunflower Plastic Type styrene Dia. 5" Slot/gauze .06 Length 15' Set between 30 ft. and 45 ft. <input type="checkbox"/> ft. and <input type="checkbox"/> ft. Gravel pack? yes Size range of material 1/4-1/8"		
				11. Static water level: 14 ft. below land surface Date 3-16-79 mo./day/yr.		
				12. Pumping level below land surfaces: ____ ft. after ____ hrs. pumping ____ g.p.m. ____ ft. after ____ hrs. pumping ____ g.p.m. Estimated maximum yield ____ g.p.m.		
				13. Water sample submitted: ____ mo./day/yr. <input checked="" type="checkbox"/> Yes <input type="checkbox"/> No Date ____		
				14. Well head completion: 12 capped <input type="checkbox"/> Pitless adapter ____ inches above grade		
				15. Well grouted? yes 1-2 fine sand mix With: <input type="checkbox"/> Neat cement <input type="checkbox"/> Bentonite <input checked="" type="checkbox"/> Concrete Depth: From 40" ft. to 14 ft.		
				16. Nearest source of possible contamination: NONE ft. ____ Direction ____ Type ____ Well disinfected upon completion? <input checked="" type="checkbox"/> Yes <input type="checkbox"/> No		
				17. Pump: <input type="checkbox"/> Not installed Manufacturer's name Jacuzzi Model number 7S4C HP 3/4 Volts 230 Length of drop pipe 30 ft. capacity 20 g.p.m. Type: <input checked="" type="checkbox"/> Submersible <input type="checkbox"/> Turbine <input type="checkbox"/> Jet <input type="checkbox"/> Reciprocating <input type="checkbox"/> Centrifugal <input type="checkbox"/> Other		
(Use a second sheet if needed)						
18. Elevation:		19. Remarks:		20. Water well contractor's certification: This well was drilled under my jurisdiction and this report is true to the best of my knowledge and belief. Harp Well & Pump 236 Business name License No. Address Wichita, Kansas Signed M. Arnold Date 5-19-79 Authorized representative		
Topography: <input type="checkbox"/> Hill <input checked="" type="checkbox"/> Slope <input type="checkbox"/> Upland <input type="checkbox"/> Valley		Septic system not installed at this time. No apparent source for contamination.				

Forward the white, blue and pink copies to the Department of Health and Environment

Form WWC-5