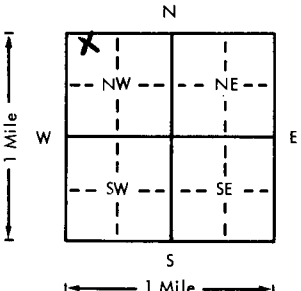


USE TYPEWRITER OR BALL  
POINT PEN-PRESS FIRMLY,  
PRINT CLEARLY.

WATER WELL RECORD  
KSA 820-1201-1215

Kansas Department of Health and  
Environment-Division of Environment  
(Water well Contractors)  
Topeka, Kansas 66620

1. Location of well:		County <b>SEDGWICK</b>	Fraction <b>NW 1/4 NW 1/4 NW 1/4</b>	Section number <b>18</b>	Township number <b>T 26 S R 1E E/W</b>	Range number
2. Distance and direction from nearest town or city: Street address of well location if in city: <b>2227 Ventoso Road Valley Center, Kansas</b>			3. Owner of well: <b>Robert Muzzy Construction</b> R.R. or street: <b>734 Butler</b> City, state, zip code: <b>Valley Center, Kansas</b>			
4. Locate with "X" in section below: Sketch map: 			6. Bore hole dia. <b>11</b> in. Completion date <b>3-28-78</b> Well depth <b>45</b> ft.			
5. Type and color of material			7. <input checked="" type="checkbox"/> Cable tool <input checked="" type="checkbox"/> Rotary <input type="checkbox"/> Driven <input type="checkbox"/> Dug <input type="checkbox"/> Hollow rod <input type="checkbox"/> Jetted <input type="checkbox"/> Bored <input type="checkbox"/> Reverse rotary			
			8. Use: <input checked="" type="checkbox"/> Domestic <input type="checkbox"/> Public supply <input type="checkbox"/> Industry <input type="checkbox"/> Irrigation <input type="checkbox"/> Air conditioning <input type="checkbox"/> Stock <input type="checkbox"/> Lawn <input type="checkbox"/> Oil field water <input type="checkbox"/> Other			
			9. Casing: Material <b>styrene</b> Weight Above or below <b>12</b> in. Threaded <input type="checkbox"/> Welded <input checked="" type="checkbox"/> Surface <b>12</b> in. RMP <input checked="" type="checkbox"/> PVC <input type="checkbox"/> Weight <b>45</b> lbs./ft. Dia. <b>5</b> in. to <b>45</b> ft. depth Wall Thickness: inches or Dia. <b>5</b> in. to <b>45</b> ft. depth gage No. <b>.200</b>			
			10. Screen: Manufacturer's name <b>Sunflower Plastic</b> Type <b>styrene</b> Dia. <b>5</b> in. Slot/size <b>.06</b> Length <b>10'</b> Set between <b>35</b> ft. and <b>45</b> ft. Gravel pack? <b>yes</b> Size range of material <b>1/4-1/8"</b>			
			11. Static water level: <b>15</b> ft. below land surface Date <b>3-28-78</b>			
			12. Pumping level below land surfaces: ft. after hrs. pumping g.p.m. ft. after hrs. pumping g.p.m. Estimated maximum yield g.p.m.			
			13. Water sample submitted: <b>Yes</b> Date			
			14. Well head completion: <input checked="" type="checkbox"/> Pitless adapter <b>12</b> inches above grade			
			15. Well grouted? <b>yes 1-2 fine sand mix</b> With: <input type="checkbox"/> Neat cement <input type="checkbox"/> Bentonite <input checked="" type="checkbox"/> Concrete Depth: From <b>40</b> ft. to <b>14</b> ft.			
			16. Nearest source of possible contamination: <b>Septic Tank</b> ft. <b>50</b> Direction <b>East</b> Type <b>Tank</b> Well disinfected upon completion? <input checked="" type="checkbox"/> Yes <input type="checkbox"/> No			
			17. Pump: <b>Not installed</b> Manufacturer's name <b>Sta-Rite</b> Model number <b>20P4D02</b> HP <b>3/4</b> Volts <b>230</b> Length of drop pipe <b>30</b> ft. capacity <b>20</b> g.p.m. Type: <input checked="" type="checkbox"/> Submersible <input type="checkbox"/> Turbine <input type="checkbox"/> Jet <input type="checkbox"/> Reciprocating <input type="checkbox"/> Centrifugal <input type="checkbox"/> Other			
18. Elevation:			19. Remarks: <b>Flat Ground</b>			
Topography: <input type="checkbox"/> Hill <input type="checkbox"/> Slope <input type="checkbox"/> Upland <input type="checkbox"/> Valley			20. Water well contractor's certification: This well was drilled under my jurisdiction and this report is true to the best of my knowledge and belief. <b>Harp Well &amp; Pump</b> <b>236</b> Business name <b>Wichita, Kansas</b> License No. Address Signed <b>M. Arnold</b> Date <b>4-22-78</b> Authorized representative			

Forward the white, blue and pink copies to the Department of Health and Environment

Form WWC-5