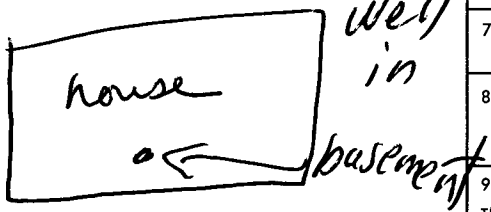


USE TYPEWRITER OR BALL
POINT PEN-PRESS FIRMLY,
PRINT CLEARLY.

WATER WELL RECORD
KSA 82a-1201-1215

Kansas Department of Health and
Environment-Division of Environment
(Water well Contractors)
Topeka, Kansas 66620

| | |
|--|--|
| 1. Location of well: County <u>Sedgwick</u> Fraction <u>SE 1/4 NW 1/4 SW 1/4</u> Section number <u>18</u> Township number <u>T 26 S</u> Range number <u>R 1 E</u> | |
| 2. Distance and direction from nearest town or city: Street address of well location if in city: <u>5529 No. Athenian Wichita, KS</u> | |
| 3. Owner of well: <u>LEEWOOD HOMES</u> R.R. or street: <u>5228 Promiss</u> City, state, zip code: <u>Wichita, KS 67294</u> | |
| 4. Locate with "X" in section below: N W E S Sketch map:  | |
| 5. Type and color of material | |
| 6. Bore hole dia. <u>1 1/2</u> in. Completion date: <u>5/6/80</u> Well depth <u>36</u> ft. | |
| 7. <input type="checkbox"/> Cable tool <input checked="" type="checkbox"/> Rotary <input type="checkbox"/> Driven <input type="checkbox"/> Dug <input type="checkbox"/> Hollow rod <input type="checkbox"/> Jetted <input type="checkbox"/> Bored <input type="checkbox"/> Reverse rotary | |
| 8. Use: <input checked="" type="checkbox"/> Domestic <input type="checkbox"/> Public supply <input type="checkbox"/> Industry <input type="checkbox"/> Irrigation <input type="checkbox"/> Air conditioning <input type="checkbox"/> Stock <input type="checkbox"/> Lawn <input type="checkbox"/> Oil field water <input type="checkbox"/> Other | |
| 9. Casing: Material <u>Steel</u> Weight: <u>12</u> lbs./ft. Above or below Threading <u>Welded</u> Surface <u>12</u> in. RMP <u>X</u> PVC Weight <u>1.50</u> lbs./ft. Dia. <u>5</u> in. to <u>36</u> ft. depth Wall Thickness: inches or Dia. <u>5</u> in. to <u>36</u> ft. depth gage No. <u>1200</u> | |
| 10. Screen: Manufacturer's name <u>Ces-MAC</u> Type <u>200</u> Dia. <u>5</u> in. Slot/gauze <u>1/16</u> Length <u>6 ft.</u> Set between <u>30</u> ft. and <u>36</u> ft. Gravel pack <u>Yes</u> Size range of material <u>3/8</u> | |
| 11. Static water level: <u>10</u> ft. below land surface Date <u>5/6/80</u> mo./day/yr. | |
| 12. Pumping level below land surfaces: <u>15</u> ft. after <u>12</u> hrs. pumping <u>20</u> g.p.m. ft. after <u>12</u> hrs. pumping <u>20</u> g.p.m. Estimated maximum yield <u>35-40</u> g.p.m. | |
| 13. Water sample submitted: <u>Yes</u> <input checked="" type="checkbox"/> No <input type="checkbox"/> Date <u>5/6/80</u> mo./day/yr. | |
| 14. Well head completion: <input type="checkbox"/> Pitless adapter <u>12</u> inches above grade | |
| 15. Well grouted? <u>Yes</u> With: <input type="checkbox"/> Neat cement <input type="checkbox"/> Bentonite <input checked="" type="checkbox"/> Concrete Depth: From <u>6</u> ft. to <u>16</u> ft. | |
| 16. Nearest source of possible contamination: ft. <u>100</u> Direction <u>W</u> Type <u>Septic</u> Well disinfected upon completion? <input checked="" type="checkbox"/> Yes <input type="checkbox"/> No | |
| 17. Pump: Manufacturer's name <u>X</u> Not installed Model number <u>HP</u> HP <u>Volts</u> Length of drop pipe <u>ft.</u> capacity <u>g.p.m.</u> Type: <input type="checkbox"/> Submersible <input type="checkbox"/> Turbine <input type="checkbox"/> Jet <input type="checkbox"/> Reciprocating <input type="checkbox"/> Centrifugal <input type="checkbox"/> Other | |
| 18. Elevation: | |
| 19. Remarks: | |
| 20. Water well contractor's certification: This well was drilled under my jurisdiction and this report is true to the best of my knowledge and belief. Business name <u>Wm. H. Bully</u> License No. <u>318</u> Address <u>Colwich</u> Signed <u>George</u> Date <u>5/6/80</u> Authorized representative | |

Forward the white, blue and pink copies to the Department of Health and Environment

Form WWC-5