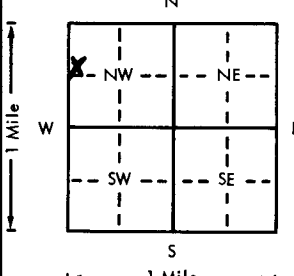
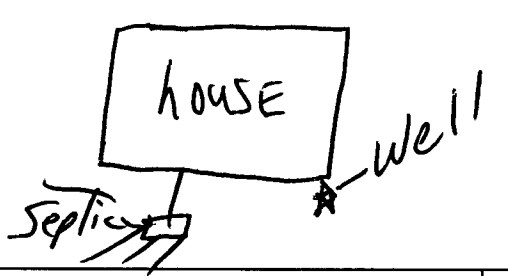


USE TYPEWRITER OR BALL
POINT PEN-PRESS FIRMLY,
PRINT CLEARLY.

WATER WELL RECORD
KSA 82a-1201-1215

Kansas Department of Health and
Environment-Division of Environment
(Water well Contractors)
Topeka, Kansas 66620

1. Location of well:		County <u>Sedg.</u>	Fraction <u>SW 1/4 NW 1/4 NW 1/4</u>	Section number <u>18</u>	Township number <u>26</u> S R <u>1</u> E W	Range number
2. Distance and direction from nearest town or city:		3. Owner of well: <u>Herb Sparks Const.</u>		R.R. or street: <u>2926 Columbine</u>		
Street address of well location if in city: <u>2025 Ventura Wichita</u>		City, state, zip code: <u>Wichita, KS 67204</u>				
4. Locate with "X" in section below:		Sketch map:		6. Bore hole dia. <u>4.5</u> in. Completion date <u>10/21/77</u> Well depth <u>45</u> ft.		
				7. <input checked="" type="checkbox"/> Cable tool <input checked="" type="checkbox"/> Rotary <input type="checkbox"/> Driven <input type="checkbox"/> Dug <input type="checkbox"/> Hollow rod <input type="checkbox"/> Jetted <input type="checkbox"/> Bored <input type="checkbox"/> Reverse rotary		
5. Type and color of material		From		To		8. Use: <input checked="" type="checkbox"/> Domestic <input type="checkbox"/> Public supply <input type="checkbox"/> Industry <input type="checkbox"/> Irrigation <input type="checkbox"/> Air conditioning <input type="checkbox"/> Stock <input type="checkbox"/> Lawn <input type="checkbox"/> Oil field water <input type="checkbox"/> Other
<u>Top Soil</u>		<u>0</u>		<u>4</u>		9. Casing: Material <u>PVC</u> Height: <u>Above</u> or below Threaded <input type="checkbox"/> Welded <input checked="" type="checkbox"/> Surface <u>1 1/2</u> in. RMP <u>PVC</u> Weight <u>2 1/2</u> lbs./ft. Dia. <u>5</u> in. to <u>4.5</u> ft. depth Wall Thickness: inches or Dia. <u>5</u> in. to <u>4.5</u> ft. depth gage No. <u>258</u>
<u>red clay</u>		<u>4</u>		<u>13</u>		10. Screen: Manufacturer's name <u>M.P.I.</u> Type <u>PVC</u> Dia. <u>5</u> in. Plot/gauge <u>1 1/16</u> Length <u>10 1/2</u> ft. Set between <u>35</u> ft. and <u>450</u> ft. Gravel pack? <u>yes</u> Size range of material <u>3/8</u>
<u>med. sand.</u>		<u>13</u>		<u>18</u>		11. Static water level: <u>15</u> ft. below land surface Date <u>10/21/77</u> mo./day/yr.
<u>clay (reddish)</u>		<u>18</u>		<u>19</u>		12. Pumping level below land surfaces: <u>16</u> ft. after <u>1/2</u> hrs. pumping <u>20</u> g.p.m. ft. after <u> </u> hrs. pumping <u> </u> g.p.m. Estimated maximum yield <u>80</u> g.p.m.
<u>med. to coarse gravel</u>		<u>19</u>		<u>45</u>		13. Water sample submitted: <u> </u> mo./day/yr. Yes <input type="checkbox"/> No <input checked="" type="checkbox"/> Date <u> </u>
<u>clay brake</u>		<u>45</u>		<u> </u>		14. Well head completion: <input checked="" type="checkbox"/> Pitless adapter <u> </u> inches above grade
						15. Well grouted? <u>yes</u> With: <input checked="" type="checkbox"/> Neat cement <input type="checkbox"/> Bentonite <input type="checkbox"/> Concrete Depth: From <u>3</u> ft. to <u>13</u> ft.
						16. Nearest source of possible contamination: ft. <u>65</u> Direction <u>S.W.</u> Type <u>Septic</u> Well disinfected upon completion? <input checked="" type="checkbox"/> Yes <input type="checkbox"/> No
						17. Pump: <u>Not installed</u> Manufacturer's name <u>Valley</u> Model number <u>1807</u> HP <u>1/2</u> Volt <u>220</u> Length of drop pipe <u>25</u> ft. capacity <u>18</u> g.p.m. Type: <input checked="" type="checkbox"/> Submersible <input type="checkbox"/> Turbine <input type="checkbox"/> Jet <input type="checkbox"/> Reciprocating <input type="checkbox"/> Centrifugal <input type="checkbox"/> Other
						20. Water well contractor's certification: This well was drilled under my jurisdiction and this report is true to the best of my knowledge and belief. <u>Weninger Duffley</u> 318 Business name License No. Address <u>Glenrich KS</u> Signed <u>J. C. Weninger</u> Date <u>10/25/77</u> Authorized representative
18. Elevation:		19. Remarks:				
Topography: <input type="checkbox"/> Hill <input type="checkbox"/> Slope <input checked="" type="checkbox"/> Upland <input type="checkbox"/> Valley		<u>Contractor to furnish 4x4x4 reinforced slab for top of well.</u>				

Forward the white, blue and pink copies to the Department of Health and Environment

Form WWC-5