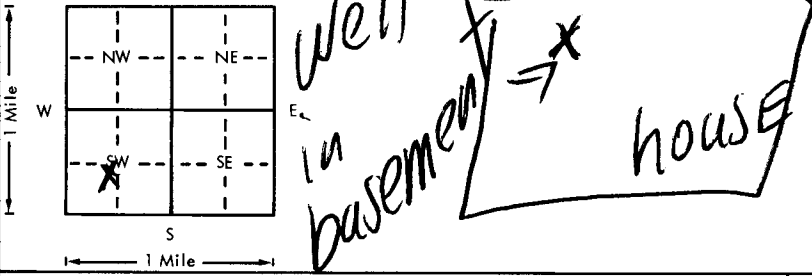


USE TYPEWRITER OR BALL
POINT PEN-PRESS FIRMLY,
PRINT CLEARLY.

WATER WELL RECORD
KSA 82a-1201-1215

Kansas Department of Health and
Environment-Division of Environment
(Water well Contractors)
Topeka, Kansas 66620

1. Location of well: County <u>Sedgwick</u> Fraction <u>NE 1/4 SW 1/4 SW 1/4</u> Section number <u>18</u> Township number <u>T 26 S</u> Range number <u>R 10 E</u>																			
2. Distance and direction from nearest town or city: <u>5710 St. Clair Wichita</u>																			
3. Owner of well: <u>LEEWOOD CONST.</u> R.R. or street: <u>5229 PRIMROSE</u> City, state, zip code: <u>Wichita KS 67204</u>																			
4. Locate with "X" in section below: Sketch map: 																			
5. Type and color of material																			
<table border="1" style="width:100%; border-collapse: collapse;"> <thead> <tr> <th></th> <th>From</th> <th>To</th> </tr> </thead> <tbody> <tr> <td><u>Top soil</u></td> <td><u>0</u></td> <td><u>2</u></td> </tr> <tr> <td><u>brown clay</u></td> <td><u>2</u></td> <td><u>8</u></td> </tr> <tr> <td><u>fine sand</u></td> <td><u>8</u></td> <td><u>22</u></td> </tr> <tr> <td><u>brown clay</u></td> <td><u>22</u></td> <td><u>23</u></td> </tr> <tr> <td><u>med to coarse gravel</u></td> <td><u>23</u></td> <td><u>40</u></td> </tr> </tbody> </table>			From	To	<u>Top soil</u>	<u>0</u>	<u>2</u>	<u>brown clay</u>	<u>2</u>	<u>8</u>	<u>fine sand</u>	<u>8</u>	<u>22</u>	<u>brown clay</u>	<u>22</u>	<u>23</u>	<u>med to coarse gravel</u>	<u>23</u>	<u>40</u>
	From	To																	
<u>Top soil</u>	<u>0</u>	<u>2</u>																	
<u>brown clay</u>	<u>2</u>	<u>8</u>																	
<u>fine sand</u>	<u>8</u>	<u>22</u>																	
<u>brown clay</u>	<u>22</u>	<u>23</u>																	
<u>med to coarse gravel</u>	<u>23</u>	<u>40</u>																	
6. Bore hole dia. <u>4 1/2</u> in. Completion date <u>1-9-80</u> Well depth <u>40</u> ft.																			
7. <input checked="" type="checkbox"/> Cable tool <input checked="" type="checkbox"/> Rotary <input type="checkbox"/> Driven <input type="checkbox"/> Dug <input type="checkbox"/> Hollow rod <input type="checkbox"/> Jetted <input type="checkbox"/> Bored <input type="checkbox"/> Reverse rotary																			
8. Use: <input checked="" type="checkbox"/> Domestic <input type="checkbox"/> Public supply <input type="checkbox"/> Industry <input type="checkbox"/> Irrigation <input type="checkbox"/> Air conditioning <input type="checkbox"/> Stock <input type="checkbox"/> Lawn <input type="checkbox"/> Oil field water <input type="checkbox"/> Other																			
9. Casing: Material <u>Super</u> Height <u>0</u> Above or below Threaded <input type="checkbox"/> Welded <input checked="" type="checkbox"/> Surface <u>1 1/2</u> in. RMP <input checked="" type="checkbox"/> PVC <input type="checkbox"/> Weight <u>1.50</u> lbs./ft. Dia. <u>5</u> in. to <u>40</u> ft. depth Wall Thickness: inches or Dia. <u>5</u> in. to <u>40</u> ft. depth gage No. <u>200</u>																			
10. Screen: Manufacturer's name <u>Per-MAC</u> Type <u>200</u> Dia. <u>5 in</u> Slot gauze <u>1 1/16</u> Length <u>10 ft</u> Set between <u>30</u> ft. and <u>40</u> ft. <u>40</u> ft. and <u>40</u> ft. Gravel pack <u>yes</u> Size range of material <u>3/8</u>																			
11. Static water level: <u>14</u> ft. below land surface Date <u>1-9-80</u> mo./day/yr.																			
12. Pumping level below land surfaces: <u>14</u> ft. after <u>1</u> hrs. pumping <u>20</u> g.p.m. <u>14</u> ft. after <u>1</u> hrs. pumping <u>20</u> g.p.m. Estimated maximum yield <u>75</u> g.p.m.																			
13. Water sample submitted: <u>14</u> mo./day/yr. <input type="checkbox"/> Yes <input checked="" type="checkbox"/> No Date <u>1-9-80</u>																			
14. Well head completion: <input type="checkbox"/> Pitless adapter <u>12</u> inches above grade																			
15. Well grouted? <u>yes</u> With: <input type="checkbox"/> Neat cement <input type="checkbox"/> Bentonite <input checked="" type="checkbox"/> Concrete Depth: From <u>6</u> ft. to <u>16</u> ft.																			
16. Nearest source of possible contamination: ft. <u>NONE</u> Direction <u>NONE</u> Type <u>NONE</u> Well disinfected upon completion? <input checked="" type="checkbox"/> Yes <input type="checkbox"/> No																			
17. Pump: <input checked="" type="checkbox"/> Not installed Manufacturer's name _____ Model number _____ HP _____ Volts _____ Length of drop pipe _____ ft. capacity _____ g.p.m. Type: <input type="checkbox"/> Submersible <input type="checkbox"/> Turbine <input type="checkbox"/> Jet <input type="checkbox"/> Reciprocating <input type="checkbox"/> Centrifugal <input type="checkbox"/> Other																			
(Use a second sheet if needed)																			
18. Elevation: Topography: <input type="checkbox"/> Hill <input type="checkbox"/> Slope <input type="checkbox"/> Upland <input checked="" type="checkbox"/> Valley	19. Remarks: <u>NEW Construction</u>																		
20. Water well contractor's certification: This well was drilled under my jurisdiction and this report is true to the best of my knowledge and belief. <u>Weninger Drilling</u> Business name <u>318</u> Address <u>Sedgwick KS</u> Signed <u>Weninger</u> Date <u>1/9/80</u> Authorized representative																			

Forward the white, blue and pink copies to the Department of Health and Environment

Form WWC-5