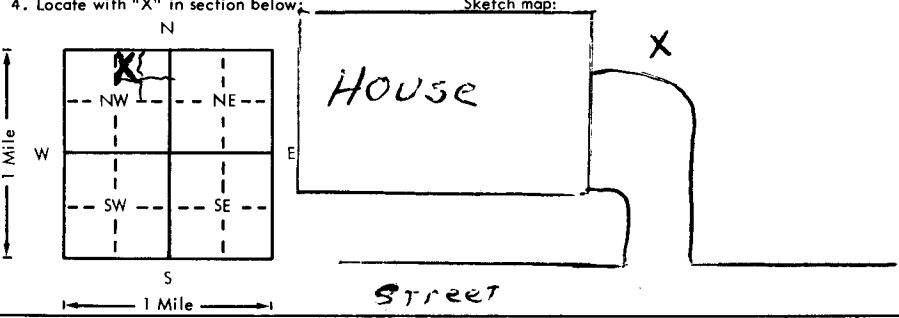


USE TYPEWRITER OR BALL
POINT PEN-PRESS FIRMLY,
PRINT CLEARLY.

WATER WELL RECORD
KSA 82a-1201-1215

Kansas Department of Health and
Environment-Division of Environment
(Water well Contractors)
Topeka, Kansas 66620

1. Location of well:		County <u>Sedgewick</u>	Fraction <u>NW 1/4 NE 1/4 NW</u>	Section number <u>18</u>	Township number <u>T 26 S</u>	Range number <u>R 1 E E/W</u>
2. Distance and direction from nearest town or city: Street address of well location if in city: <u>2126 W 60th No</u>				3. Owner of well: <u>Michael Sanders</u> R.R. or street: <u>2122 W 60th</u> City, state, zip code: <u>Wichita Kansas</u>		
4. Locate with "X" in section below:		Sketch map:		6. Bore hole dia. <u>11</u> in. Completion date <u>3-6-78</u> Well depth <u>27</u> ft.		
				7. <input type="checkbox"/> Cable tool <input type="checkbox"/> Rotary <input type="checkbox"/> Driven <input type="checkbox"/> Dug <input type="checkbox"/> Hollow rod <input type="checkbox"/> Jetted <input checked="" type="checkbox"/> Bored <input type="checkbox"/> Reverse rotary		
5. Type and color of material		From	To	8. Use: <input type="checkbox"/> Domestic <input type="checkbox"/> Public supply <input type="checkbox"/> Industry <input checked="" type="checkbox"/> Irrigation <input type="checkbox"/> Air conditioning <input type="checkbox"/> Stock <input checked="" type="checkbox"/> Lawn <input type="checkbox"/> Oil field water <input type="checkbox"/> Other		
<u>Clay & Topsoil</u>		<u>0</u>	<u>5</u>	9. Casing: Material <u>PVC</u> Height: Above or below Threaded <input type="checkbox"/> Welded <input type="checkbox"/> Surface <u>12</u> in. RMP <input type="checkbox"/> PVC <input checked="" type="checkbox"/> Weight <u>2.758</u> lbs./ft. Dia. <u>5</u> in. to <u>27</u> ft. depth Wall Thickness: inches or Dia. <u> </u> in. to <u> </u> ft. depth gage No. <u>1258</u>		
<u>Silty Sand</u>		<u>6</u>	<u>18</u>	10. Screen: Manufacturer's name <u>Modern Pipe</u> Type <u>PVC</u> Dia. <u>5"</u> Slot/gauze <u>.025</u> Length <u>5'</u> Set between <u>22</u> ft. and <u>27</u> ft. <u> </u> ft. and <u> </u> ft. Gravel pack? <u>NO</u> Size range of material <u> </u>		
<u>Gravel</u>		<u>19</u>	<u>27</u>	11. Static water level: <u> </u> mo./day/yr. <u>19</u> ft. below land surface Date <u>3-6-78</u>		
				12. Pumping level below land surfaces: <u>18</u> ft. after <u>1</u> hrs. pumping <u>22</u> g.p.m. <u> </u> ft. after <u> </u> hrs. pumping <u> </u> g.p.m. Estimated maximum yield <u>507</u> g.p.m.		
				13. Water sample submitted: <u> </u> mo./day/yr. <u> </u> Yes <input checked="" type="checkbox"/> No <input type="checkbox"/> Date <u> </u>		
				14. Well head completion: <u> </u> Pitless adapter <u>12</u> inches above grade		
				15. Well grouted? <u>YES</u> With: <u> </u> Neat cement <input checked="" type="checkbox"/> Bentonite <input checked="" type="checkbox"/> Concrete <input type="checkbox"/> Depth: From <u>0</u> ft. to <u>10</u> ft.		
				16. Nearest source of possible contamination: ft. <u>120'</u> Direction <u>WEST</u> Type <u>SEWER</u> Well disinfected upon completion? <u> </u> Yes <input checked="" type="checkbox"/> No <input type="checkbox"/>		
				17. Pump: <input checked="" type="checkbox"/> Not installed Manufacturer's name <u> </u> Model number <u> </u> HP <u> </u> Volts <u> </u> Length of drop pipe <u> </u> ft. capacity <u> </u> g.p.m. Type: <u> </u> Submersible <u> </u> Turbine <u> </u> Jet <u> </u> Reciprocating <u> </u> Centrifugal <u> </u> Other		
		(Use a second sheet if needed)				
18. Elevation:		19. Remarks:		20. Water well contractor's certification: This well was drilled under my jurisdiction and this report is true to the best of my knowledge and belief. <u>21st Elm St</u> <u>129</u> Business name <u>512 W. 21st</u> License No. <u>WIC-17A</u> Address <u>Wichita</u> Signed <u>J. Hansen</u> Date <u>3-27-78</u> Authorized representative		
Topography: <u> </u> Hill <u> </u> Slope <u> </u> Upland <u> </u> Valley						

Forward the white, blue and pink copies to the Department of Health and Environment

Form WWC-5