

LOCATION OF WATER WELL: Fraction NW 1/4 NE 1/4 SW 1/4 Section Number 18 Township Number T 26 S Range Number R 10 E/W

County: Sedg. Distance and direction from nearest town or city street address of well if located within city?

5760 No Athenian Wichita

WATER WELL OWNER: LEEWOOD HOMES.


RR#, St. Address, Box #: 6130 Legoin

City, State, ZIP Code: Wichita KS 67204

Board of Agriculture, Division of Water Resources

Application Number:

LOCATE WELL'S LOCATION WITH AN "X" IN SECTION BOX:

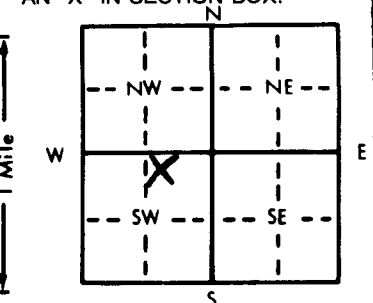

DEPTH OF COMPLETED WELL: 42 ft. ELEVATION:

Depth(s) Groundwater Encountered 1. 20 ft. 2. 20 ft. 3. 20 ft.

WELL'S STATIC WATER LEVEL 20 ft. below land surface measured on mo/day/yr 6-6-81

Pump test data: Well water was 20 ft. after 16 hours pumping 20 gpm

Est. Yield 40 gpm: Well water was 20 ft. after 16 hours pumping 20 gpm

Bore Hole Diameter 11 in. to 42 ft., and 42 in. to 42 ft.

WELL WATER TO BE USED AS: 5 Public water supply 8 Air conditioning 11 Injection well

1 Domestic 3 Feedlot 6 Oil field water supply 9 Dewatering 12 Other (Specify below)

2 Irrigation 4 Industrial 7 Lawn and garden only 10 Observation well

Was a chemical/bacteriological sample submitted to Department? Yes X No X; If yes, mo/day/yr sample was submitted

Water Well Disinfected? Yes X No X

TYPE OF BLANK CASING USED:

1 Steel 3 RMP (SR)

2 PVC 4 ABS

Blank casing diameter 5 in. to 32 ft., Dia 32 in. to 42 ft., Dia 42 in. to 42 ft.

Casing height above land surface 12 in., weight 1.59 lbs./ft. Wall thickness or gauge No SPR-26

TYPE OF SCREEN OR PERFORATION MATERIAL:

1 Steel 3 Stainless steel

2 Brass 4 Galvanized steel

5 Fiberglass

6 Concrete tile

7 PVC

8 RMP (SR)

10 Asbestos-cement

11 Other (specify)

12 None used (open hole)

SCREEN OR PERFORATION OPENINGS ARE:

1 Continuous slot

2 Louvered shutter

3 Mill slot

4 Key punched

5 Gauzed wrapped

6 Wire wrapped

7 Torch cut

8 Saw cut

9 Drilled holes

10 Other (specify)

11 None (open hole)

SCREEN-PERFORATED INTERVALS: From 32 ft. to 42 ft., From 32 ft. to 42 ft., From 32 ft. to 42 ft.

GRAVEL PACK INTERVALS: From 15 ft. to 42 ft., From 15 ft. to 42 ft., From 15 ft. to 42 ft.

GROUT MATERIAL:

1 Neat cement

2 Cement grout

3 Bentonite

4 Other

Grout intervals: From 5 ft. to 15 ft., From 5 ft. to 15 ft., From 5 ft. to 15 ft.

What is the nearest source of possible contamination:

1 Septic tank

2 Sewer lines

3 Watertight sewer lines 6 Seepage pit

4 Lateral lines

5 Cess pool

7 Pit privy

8 Sewage lagoon

9 Feedyard

10 Livestock pens

11 Fuel storage

12 Fertilizer storage

13 Insecticide storage

14 Abandoned water well

15 Oil well/Gas well

16 Other (specify below)

Direction from well? SE

How many feet? 70

FROM	TO	LITHOLOGIC LOG	FROM	TO	LITHOLOGIC LOG
0-2	2	Top ss. l.			
2-18	18	Red clay			
18-28	28	fine sand			
28-29	29	Red clay			
29-42	42	med gravel			

CONTRACTOR'S OR LANDOWNER'S CERTIFICATION: This water well was (1) constructed, (2) reconstructed, or (3) plugged under my jurisdiction and was completed on (mo/day/year) 6-6-81 and this record is true to the best of my knowledge and belief. Kansas

Water Well Contractor's License No. 318 This Water Well Record was completed on (mo/day/yr) 6-26-81

under the business name of Wenger Drilling by (signature) Wenger

INSTRUCTIONS: Use typewriter or ball point pen, PLEASE PRESS FIRMLY and PRINT clearly. Please fill in blanks, underline or circle the correct answers. Send top three copies to Kansas Department of Health and Environment, Division of Environment, Environmental Geology Section, Topeka, KS 66620. Send one to WATER WELL OWNER and retain one for your records.

OFFICE USE ONLY

T

R

E/W

SEC. 18

NE 1/4

NE 1/4

SW 1/4