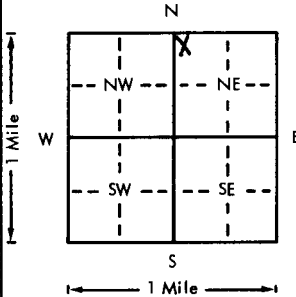
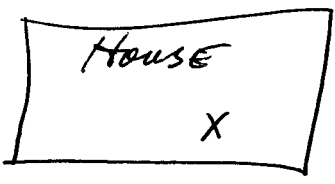


USE TYPEWRITER OR BALL  
POINT PEN-PRESS FIRMLY,  
PRINT CLEARLY.

WATER WELL RECORD  
KSA 82a-1201-1215

Kansas Department of Health and  
Environment-Division of Environment  
(Water well Contractors)  
Topeka, Kansas 66620

1. Location of well:	County <u>Sedgewick SW</u>	Fraction <u>NW 1/4 NW 1/4 NE 1/4</u>	Section number <u>218</u>	Township number <u>26</u>	Range number <u>1E</u>	E/W
2. Distance and direction from nearest town or city: Street address of well location if in city: <u>6130 Legion</u>			3. Owner of well: <u>MARIE GLAZIER</u> R.R. or street: <u>6130 Legion</u> City, state, zip code: <u>WICHITA, KS.</u>			
4. Locate with "X" in section below: 			Sketch map: 		6. Bore hole dia. <u>8</u> in. Completion date <u>6-6-77</u> Well depth <u>20</u> ft.	
5. Type and color of material			From	To	7. <input type="checkbox"/> Cable tool <input type="checkbox"/> Rotary <input type="checkbox"/> Driven <input type="checkbox"/> Dug <input type="checkbox"/> Hollow rod <input type="checkbox"/> Jetted <input checked="" type="checkbox"/> Bored <input type="checkbox"/> Reverse rotary	
			8. Use: <input checked="" type="checkbox"/> Domestic <input type="checkbox"/> Public supply <input type="checkbox"/> Industry <input type="checkbox"/> Irrigation <input type="checkbox"/> Air conditioning <input type="checkbox"/> Stock <input type="checkbox"/> Lawn <input type="checkbox"/> Oil field water <input type="checkbox"/> Other			
			9. Casing: Material <u>Steel</u> Height: Above or below Threaded <input type="checkbox"/> Welded <input checked="" type="checkbox"/> Surface <u>12</u> in. RMP <input type="checkbox"/> PVC <input type="checkbox"/> Weight <u>65</u> lbs./ft. Dia. <u>5</u> in. to <u>20</u> ft. depth Wall thickness: inches or Dia. <u>5</u> in. to <u>20</u> ft. depth gage No. <u>200 mnc</u>			
			10. Screen: Manufacturer's name <u>JFL</u> Type <u>200</u> Dia. <u>5"</u> Slot/gauze <u>0.065</u> Length <u>5'</u> Set between <u>15</u> ft. and <u>20</u> ft. Gravel pack? <u>no</u> Size range of material			
			11. Static water level: <u>10</u> ft. below land surface Date <u>6-6-77</u> 12. Pumping level below land surfaces: <u>8</u> ft. after <u>1</u> hrs. pumping <u>15</u> g.p.m. <u>   </u> ft. after <u>   </u> hrs. pumping <u>   </u> g.p.m. Estimated maximum yield <u>50</u> g.p.m.			
13. Water sample submitted: <u>   </u> mo./day/yr. <u>   </u> Yes <input checked="" type="checkbox"/> No <input type="checkbox"/> Date <u>   </u>			14. Well head completion: <u>   </u> Pitless adapter <u>12"</u> inches above grade			
			15. Well grouted? <u>NO</u> With: <u>   </u> Neat cement <u>   </u> Bentonite <u>   </u> Concrete Depth: From <u>   </u> ft. to <u>   </u> ft.			
			16. Nearest source of possible contamination: ft. <u>200</u> Direction <u>E.</u> Type <u>River</u> Well disinfected upon completion? <u>YES</u> <input checked="" type="checkbox"/> No <input type="checkbox"/>			
			17. Pump: Manufacturer's name <u>   </u> <input checked="" type="checkbox"/> Not installed Model number <u>   </u> HP <u>   </u> Volts <u>   </u> Length of drop pipe <u>   </u> ft. capacity <u>   </u> g.p.m. Type: <input type="checkbox"/> Submersible <input type="checkbox"/> Turbine <input type="checkbox"/> Jet <input type="checkbox"/> Reciprocating <input type="checkbox"/> Centrifugal <input type="checkbox"/> Other			
			(Use a second sheet if needed)			20. Water well contractor's certification: This well was drilled under my jurisdiction and this report is true to the best of my knowledge and belief. <u>2157 Electric</u> <u>129</u> Business name <u>512 W. 2157</u> License No. Address <u>   </u> Signed <u>J. Namis</u> Date <u>6-9-77</u> Authorized representative
18. Elevation: Topography: <input type="checkbox"/> Hill <input type="checkbox"/> Slope <input type="checkbox"/> Upland <input checked="" type="checkbox"/> Valley		19. Remarks: <u>Well installed on</u> <u>ARKANSAS RIVER BANK.</u> <u>CUSTOMER TO DISINFECT &amp; DO</u> <u>CONCRETE WORK. SIGNATURE ON WORK</u>				

Forward the white, blue and pink copies to the Department of Health and Environment

Form WWC-5