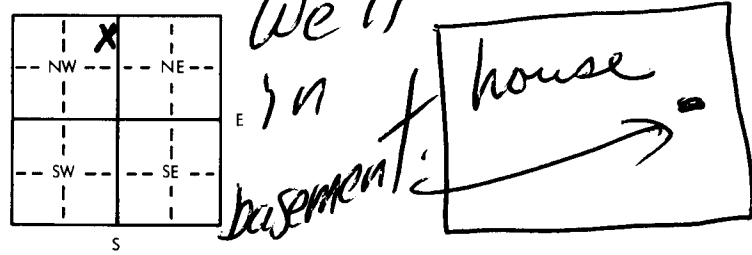


USE TYPEWRITER OR BALL
POINT PEN-PRESS FIRMLY,
PRINT CLEARLY.

WATER WELL RECORD
KSA 82a-1201-1215

Kansas Department of Health and
Environment-Division of Environment
(Water well Contractors)
Topeka, Kansas 66620

1. Location of well: <u>Sedgewick</u> County		Fraction: <u>NE NE NW 1/4</u>	Section number: <u>18</u>	Township number: <u>26</u> S	Range number: <u>1</u> E	
2. Distance and direction from nearest town or city: Street address of well location if in city: <u>1901 W. 60th No. Wichita</u>			3. Owner of well: <u>Clint Renollet</u> R.R. or street: <u>3245 W 47th So.</u> City, state, zip code: <u>Wichita 67217</u>			
4. Locate with "X" in section below: N W E S 1 Mile 1 Mile		Sketch map: 		6. Bore hole dia. <u>4 1/2</u> in. Completion date: <u>2/21/79</u> Well depth <u>44</u> ft.		
5. Type and color of material		From	To	7. ☐ Cable tool ☒ Rotary ☐ Driven ☐ Dug ☐ Hollow rod ☐ Jetted ☐ Bored ☐ Reverse rotary		
Top Soil		0	2	8. Use: ☒ Domestic ☐ Public supply ☐ Industry ☐ Irrigation ☐ Air conditioning ☐ Stock ☐ Laws ☐ Oil field water ☐ Other		
Red clay.		2	8	9. Casing: Material <u>Steel</u> Height: <u>0</u> in. Threaded ☐ Welded ☒ Surface <u>0</u> in. RMP ☒ PVC ☐ Weight <u>1.50</u> lbs./ft. Dia. <u>5</u> in. to <u>4 1/2</u> ft. depth Wall Thickness: inches or Dia. <u>5</u> in. to <u>4 1/2</u> ft. depth gage No. <u>1200</u>		
fine to med sand.		8	27	10. Screen: Manufacturer's name <u>Sunflower</u> Type <u>200</u> Dia. <u>5</u> in. Slot/auze <u>1/16</u> Length <u>6</u> ft. Set between <u>37</u> ft. and <u>43</u> ft. Gravel pack <u>yes</u> Size range of material		
gray clay.		27	33	11. Static water level: <u>15</u> ft. below land surface Date <u>2/21/79</u> mo./day/yr.		
med gravel		33	44	12. Pumping level below land surfaces: <u>16</u> ft. after <u>12</u> hrs. pumping <u>15</u> g.p.m. <u>16</u> ft. after <u>12</u> hrs. pumping <u>15</u> g.p.m. Estimated maximum yield <u>25-40</u> g.p.m.		
gray clay		44		13. Water sample submitted: <u>Yes</u> ☒ No ☐ Date		
				14. Well head completion: ☐ Pitless adapter <u>12</u> inches above grade		
				15. Well grouted? <u>yes</u> With: ☐ Neat cement ☐ Bentonite ☒ Concrete Depth: From <u>6</u> ft. to <u>16</u> ft.		
				16. Nearest source of possible contamination: ft. <u>100</u> Direction <u>So</u> Type <u>Lake</u> Well disinfected upon completion? ☒ Yes ☐ No		
				17. Pump: Manufacturer's name ☒ Not installed Model number <u>318</u> HP <u>1</u> Volts <u>115</u> Length of drop pipe <u>12</u> ft. capacity <u>15</u> g.p.m. Type: ☐ Submersible ☐ Turbine ☐ Jet ☐ Reciprocating ☐ Centrifugal ☐ Other		
18. Elevation:		19. Remarks:		20. Water well contractor's certification: This well was drilled under my jurisdiction and this report is true to the best of my knowledge and belief. <u>Richard Dilly</u> 318 Business name <u>Dilly</u> License No. <u>2/21/79</u> Address <u>3245 W 47th So.</u> Signature <u>Richard Dilly</u> Date <u>2/21/79</u> Authorized representative		

Forward the white, blue and pink copies to the Department of Health and Environment

Form WWC-5