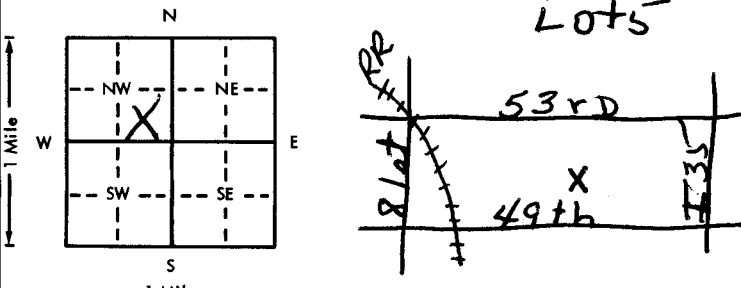


USE TYPEWRITER OR BALL
POINT PEN—PRESS FIRMLY,
PRINT CLEARLY.

WATER WELL RECORD
KSA 82a-1201-1215

Kansas Department of Health and
Environment—Division of Environment
(Water well Contractors)
Topeka, Kansas 66620

NE SW NE NW

1. Location of well: County <u>Sedgwick</u> Fraction <u>1/4 1/4 1/4</u> Section number <u>21</u> Township number <u>T 26</u> Range number <u>S R 1</u> <u>EW</u>	
2. Distance and direction from nearest town or city: <u>2mi No Wichita</u> 3. Owner of well: <u>Joe Lee</u> Street address of well location if in city: <u>5228 Primrose</u> R.R. or street: <u>5228 Primrose</u> City, state, zip code: <u>Wichita KS</u>	
4. Locate with "X" in section below: Sketch map: <u>Lot 5</u> 	
5. Type and color of material	
6. Bore hole dia. _____ in. Completion date: <u>2/4/10</u> Well depth <u>35</u> ft.	
7. _____ Cable tool _____ Rotary _____ Driven _____ Dug _____ Hollow rod _____ Jetted _____ Bored _____ Reverse rotary	
8. Use: _____ Domestic _____ Public supply _____ Industry _____ Irrigation _____ Air conditioning _____ Stock _____ Lawn _____ Oil field water _____ Other	
9. Casing: Material _____ Height: Above or below Threaded _____ Welded _____ Surface <u>12</u> in. RMP <u>X</u> PVC _____ Weight <u>100</u> lbs./ft. Dia. <u>5</u> in. to <u>35</u> ft. depth Wall Thickness: inches or Dia. _____ in. to _____ ft. depth Gauge No. <u>100</u>	
10. Screen: Manufacturer's name <u>Sunflower</u> Type <u>100</u> Dia. <u>5"</u> Slot/gauze <u>Slot</u> Length <u>5'</u> Set between <u>30</u> ft. and <u>35</u> ft. _____ ft. and _____ ft. Gravel pack? <u>No</u> Size range of material _____	
11. Static water level: _____ mo./day/yr. <u>13</u> ft. below land surface Date <u>12-4-16</u>	
12. Pumping level below land surfaces: _____ ft. after _____ hrs. pumping _____ g.p.m. _____ ft. after _____ hrs. pumping _____ g.p.m. Estimated maximum yield <u>5</u> g.p.m.	
13. Water sample submitted: _____ mo./day/yr. Yes _____ No _____ Date _____	
14. Well head completion: _____ Pitless adapter <u>12</u> inches above grade	
15. Well grouted? <u>Owner</u> With: _____ Neat cement _____ Bentonite _____ Concrete Depth: From _____ ft. to _____ ft.	
16. Nearest source of possible contamination: ft. <u>400</u> Direction <u>NW</u> Type <u>Sewer</u> Well disinfected upon completion? <u>Yes</u> Yes _____ No _____	
17. Pump: <u>Not installed</u> Manufacturer's name _____ Model number _____ HP _____ Volts _____ Length of drop pipe _____ ft. capacity _____ g.p.m. Type: _____ Submersible _____ Turbine _____ Jet _____ Reciprocating _____ Centrifugal _____ Other _____	
(Use a second sheet if needed)	
18. Elevation: Topography: _____ Hill _____ Slope _____ Upland <u>X</u> Valley	19. Remarks: <u>Wire sorry, this report was misplaced.</u>
20. Water well contractor's certification: This well was drilled under my jurisdiction and this report is true to the best of my knowledge and belief. <u>Jet Drilling</u> <u>313</u> Business name _____ License No. _____ Address <u>257 N. Sabin</u> Signed <u>Kenji Lander</u> Date _____ Authorized representative	