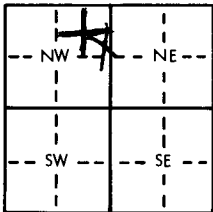
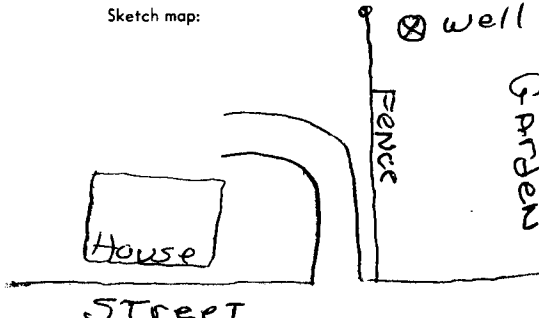


USE TYPEWRITER OR BALL
POINT PEN-PRESS FIRMLY,
PRINT CLEARLY.

WATER WELL RECORD
KSA 82a-1201-1215

Kansas Department of Health and
Environment-Division of Environment
(Water well Contractors)
Topeka, Kansas 66620

1. Location of well:		County Sedgwick	Section SE-NE-NW NE-NE-NE 1/4	Section number 19	Township number T 26	Range number S R 1	EW
2. Distance and direction from nearest town or city: Wichita			3. Owner of well: LARRY YATES				
Street address of well location if in city: 5224 N. Delaware			R.R. or street: 5224 N. Delaware				
			City, state, zip code: Wichita, KS.				
4. Locate with "X" in section below: 		Sketch map: 		6. Bore hole dia. 11 in. Completion date 7-28-78 Well depth 29 ft.			
				7. Cable tool <input type="checkbox"/> Rotary <input type="checkbox"/> Driven <input type="checkbox"/> Dug Hollow rod <input type="checkbox"/> Jetted <input checked="" type="checkbox"/> Bored <input type="checkbox"/> Reverse rotary			
				8. Use: Domestic <input type="checkbox"/> Public supply <input type="checkbox"/> Industry Irrigation <input type="checkbox"/> Air conditioning <input type="checkbox"/> Stock <input checked="" type="checkbox"/> Lawn <input type="checkbox"/> Oil field water <input type="checkbox"/> Other			
				9. Casing: Material PVC Height: Above or below Threaded <input type="checkbox"/> Welded <input type="checkbox"/> Surface 12 in. RMP <input type="checkbox"/> PVC <input checked="" type="checkbox"/> Weight 2.750 lbs./ft. Dia. 5 in. to 29 ft. depth; Wall Thickness: inches or Dia. <input type="checkbox"/> in. to <input type="checkbox"/> ft. depth; gage No. 258			
5. Type and color of material		From To		10. Screen: Manufacturer's name Modern			
Topsoil		0 6		Type PVC Dia. 5.563			
DIRT-SAND		7 17		Slot/gauze .025 Length 5'			
SAND		18 23		Set between 23 ft. and 28 ft.			
GRAVEL		24 29		Gravel pack? NO Size range of material			
				11. Static water level: 18 ft. below land surface Date 7-28-78			
				12. Pumping level below land surfaces: 18 ft. after 1 hrs. pumping 20 g.p.m. _____ ft. after _____ hrs. pumping _____ g.p.m. Estimated maximum yield 75 g.p.m.			
				13. Water sample submitted: _____ mo./day/yr. Yes <input type="checkbox"/> No <input checked="" type="checkbox"/> Date _____			
				14. Well head completion: Pitless adapter 12 Inches above grade			
				15. Well grouted? YES With: Neat cement <input checked="" type="checkbox"/> Bentonite <input type="checkbox"/> Concrete <input type="checkbox"/> Depth: From 0 ft. to 10 ft.			
				16. Nearest source of possible contamination: ft. 62 Direction NW Type SEWERS Well disinfected upon completion? <input checked="" type="checkbox"/> Yes <input type="checkbox"/> No			
				17. Pump: Not installed Manufacturer's name _____ Model number _____ HP _____ Volts _____ Length of drop pipe _____ ft. capacity _____ g.p.m. Type: _____ Submersible _____ Turbine _____ Jet _____ Reciprocating _____ Centrifugal _____ Other			
				(Use a second sheet if needed)			
18. Elevation:		19. Remarks:		20. Water well contractor's certification: This well was drilled under my jurisdiction and this report is true to the best of my knowledge and belief. 21st Electric Co. 129 Business name _____ License No. _____ Address 512 W. 21 Wichita Signed J. Harris Date 8-22-78 Authorized representative			
Topography: _____ Hill _____ Slope _____ Upland <input checked="" type="checkbox"/> Valley							

Forward the white, blue and pink copies to the Department of Health and Environment

Form WWC-5