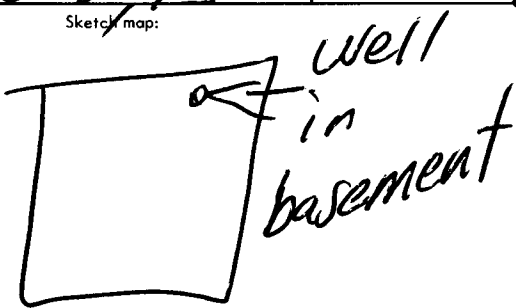


USE TYPEWRITER OR BALL  
POINT PEN-PRESS FIRMLY,  
PRINT CLEARLY.

WATER WELL RECORD  
KSA 82a-1201-1215

Kansas Department of Health and  
Environment-Division of Environment  
(Water well Contractors)  
Topeka, Kansas 66620

1. Location of well: <u>Sedgwick NW 1/4 SE 1/4</u>		Section number <u>19</u>		Township number <u>26</u> S <u>1</u> E <u>W</u>	
2. Distance and direction from nearest town or city: Street address of well location if in city: <u>#138 Alexander W, KS</u>		3. Owner of well: <u>C.M. Pennington</u> R.R. or street: <u>1420 No. McCarmel</u> City, state, zip code: <u>Wichita, 67203</u>			
4. Locate with "X" in section below: N W E S 1 Mile 1 Mile		Sketch map: 		6. Bore hole dia. <u>4 1/2</u> in. Completion date <u>4/8/79</u> Well depth <u>43</u> ft.	
				7. <input checked="" type="checkbox"/> Cable tool <input checked="" type="checkbox"/> Rotary <input type="checkbox"/> Driven <input type="checkbox"/> Dug <input type="checkbox"/> Hollow rod <input type="checkbox"/> Jetted <input type="checkbox"/> Bored <input type="checkbox"/> Reverse rotary	
				8. Use: <input checked="" type="checkbox"/> Domestic <input type="checkbox"/> Public supply <input type="checkbox"/> Industry <input type="checkbox"/> Irrigation <input type="checkbox"/> Air conditioning <input type="checkbox"/> Stock <input type="checkbox"/> Lawn <input type="checkbox"/> Oil field water <input type="checkbox"/> Other	
				9. Casing: <u>Steel</u> Height: <u>12</u> Above or below Threaded <input checked="" type="checkbox"/> Welded <input checked="" type="checkbox"/> Surface <input type="checkbox"/> RMP <input checked="" type="checkbox"/> PV <input type="checkbox"/> Weight <u>1.50</u> lbs./ft. Dia. <u>5</u> in. to <u>4 1/2</u> ft. depth Wall Thickness: inches or Dia. <u>5</u> in. to <u>4 1/2</u> ft. depth gage No. <u>200</u>	
5. Type and color of material		From To		10. Screen: Manufacturer's name <u>Surflower</u> Type <u>200</u> Dia. <u>5 in</u> Plot gauge <u>1 1/16</u> Length <u>6 ft</u> Set between <u>37</u> ft. and <u>43</u> ft. Gravel pack <u>yes</u> size range of material <u>3/8</u>	
<u>Top soil</u>		<u>0 3</u>		11. Static water level: <u>15</u> ft. below land surface Date <u>4/8/79</u>	
<u>red clay</u>		<u>3 13</u>		12. Pumping level below land surfaces: <u>17</u> ft. after <u>12</u> hrs. pumping <u>15</u> g.p.m. <u>17</u> ft. after <u>12</u> hrs. pumping <u>15</u> g.p.m. Estimated maximum yield <u>30-40</u> g.p.m.	
<u>fine to med sand</u>		<u>13 31</u>		13. Water sample submitted: <u>no./day/yr.</u>	
<u>red clay</u>		<u>31 32</u>		<u>Yes</u> <input checked="" type="checkbox"/> <u>No</u> <input type="checkbox"/> Date <u>4/8/79</u>	
<u>coarse gravel</u>		<u>31 43</u>		14. Well head completion: <u>12</u> Pitless adapter <u>12</u> inches above grade	
<u>gray clay</u>		<u>43</u>		15. Well grouted? <u>yes</u> With: <u>Neat cement</u> <u>Bentonite</u> <input checked="" type="checkbox"/> <u>Concrete</u> Depth: From <u>16</u> ft. to <u>16</u> ft.	
				16. Nearest source of possible contamination: <u>City</u> ft. <u>40</u> Direction <u>SE</u> Type <u>Septic tank</u> Well disinfected upon completion? <input checked="" type="checkbox"/> <u>Yes</u> <input type="checkbox"/> <u>No</u>	
				17. Pump: Manufacturer's name <u>X</u> Not installed Model number <u>        </u> HP <u>        </u> Volts <u>        </u> Length of drop pipe <u>        </u> ft. capacity <u>        </u> g.p.m. Type: <input type="checkbox"/> Submersible <input type="checkbox"/> Turbine <input type="checkbox"/> Jet <input type="checkbox"/> Reciprocating <input type="checkbox"/> Centrifugal <input type="checkbox"/> Other	
				20. Water well contractor's certification: This well was drilled under my jurisdiction and this report is true to the best of my knowledge and belief. <u>Wenger</u> <u>318</u> Business name <u>Sedgwick</u> License No. <u>        </u> Address <u>        </u> Signed <u>        </u> Date <u>4/8/79</u> Authorized representative	
18. Elevation:		19. Remarks: <u>New Construction</u>			
Topography: <input type="checkbox"/> Hill <input type="checkbox"/> Slope <input type="checkbox"/> Upland <input type="checkbox"/> Valley					

Forward the white, blue and pink copies to the Department of Health and Environment

Form WWC-5