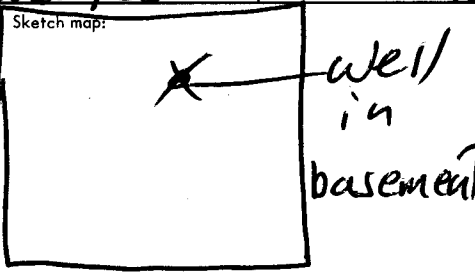


USE TYPEWRITER OR BALL
POINT PEN-PRESS FIRMLY,
PRINT CLEARLY.

WATER WELL RECORD
KSA 82a-1201-1215

Kansas Department of Health and
Environment-Division of Environment
(Water well Contractors)
Topeka, Kansas 66620

1. Location of well:		County <u>Sedg.</u> NE <u>SW</u> $\frac{1}{4}$ NE $\frac{1}{4}$ SE <u>4</u>	Section number <u>19</u>	Township number T <u>26</u> S <u>1</u> R <u>EW</u>	Range number
2. Distance and direction from nearest town or city: Street address of well location if in city: <u>4826 Bison Wichita KS</u>			3. Owner of well: <u>C.M. Pennington</u> R.R. or street: <u>1420 N. Mt. Camel</u> City, state, zip code: <u>Wichita KS 67203</u>		
4. Locate with "X" in section below: N W E S 1 Mile		Sketch map: 		6. Bore hole dia. <u>4</u> in. Completion date: <u>5/4/78</u> Well depth <u>49</u> ft.	
5. Type and color of material		From To		7. <input checked="" type="checkbox"/> Cable tool <input checked="" type="checkbox"/> Rotary <input type="checkbox"/> Driven <input type="checkbox"/> Dug <input type="checkbox"/> Hollow rod <input type="checkbox"/> Jetted <input type="checkbox"/> Bored <input type="checkbox"/> Reverse rotary	
				8. Use: <input checked="" type="checkbox"/> Domestic <input type="checkbox"/> Public supply <input type="checkbox"/> Industry <input type="checkbox"/> Irrigation <input type="checkbox"/> Air conditioning <input type="checkbox"/> Stock <input type="checkbox"/> Law <input type="checkbox"/> Oil field water <input type="checkbox"/> Other	
				9. Casing: Material <u>Styrene</u> Height: Above or below Threading <u>Welded</u> <input checked="" type="checkbox"/> Surface <u>12</u> in. RMP <input checked="" type="checkbox"/> PVC <input type="checkbox"/> Weight <u>1.50</u> lbs./ft. Dia. <u>5</u> in. to <u>49</u> ft. depth Wall Thickness: inches or Dia. <u>5</u> in. to <u>49</u> ft. depth gage No. <u>200</u>	
				10. Screen: Manufacturer's name <u>Sunflower</u> Type <u>200</u> Dia. <u>5</u> in. Slot/auze <u>1/16</u> Length <u>49</u> ft. Set between <u>39</u> ft. and <u>49</u> ft. Gravel pack? <u>yes</u> Size range of material <u>3/8</u>	
Top soil Red clay med. sand red clay course gravel clay.		11. Static water level: <u>17</u> ft. below land surface Date <u>5/4/78</u>		12. Pumping level below land surfaces: <u>18</u> ft. after <u>12</u> hrs. pumping <u>20</u> g.p.m. <u>49</u> ft. after <u>12</u> hrs. pumping <u>100</u> g.p.m. Estimated maximum yield <u>100</u> g.p.m.	
				13. Water sample submitted: <u>no.</u> /day/yr. Yes <input checked="" type="checkbox"/> No <input type="checkbox"/> Date	
				14. Well head completion: <input type="checkbox"/> Pitless adapter <u>12</u> inches above grade	
				15. Well grouted? <u>yes</u> With: <input type="checkbox"/> Neat cement <input type="checkbox"/> Bentonite <input checked="" type="checkbox"/> Concrete Depth: From <u>6</u> ft. to <u>16</u> ft.	
				16. Nearest source of possible contamination: fr. <u>None</u> Direction <u>None</u> Type <u>None</u> Well disinfected upon completion? <input checked="" type="checkbox"/> Yes <input type="checkbox"/> No	
				17. Pump: <input checked="" type="checkbox"/> Not installed Manufacturer's name <u>X</u> Model number <u> </u> HP <u> </u> Volts <u> </u> Length of drop pipe <u> </u> ft. capacity <u> </u> g.p.m. Type: <input type="checkbox"/> Submersible <input type="checkbox"/> Turbine <input type="checkbox"/> Jet <input type="checkbox"/> Reciprocating <input type="checkbox"/> Centrifugal <input type="checkbox"/> Other	
(Use a second sheet if needed)					
18. Elevation:	19. Remarks:		20. Water well contractor's certification: This well was drilled under my jurisdiction and this report is true to the best of my knowledge and belief. <u>Wenger Dilling</u> 318 Business name <u>Colwich</u> License No. <u> </u> Address <u> </u> Signed <u>J. Pennington</u> 5/4/78 Authorized representative		

Forward the white, blue and pink copies to the Department of Health and Environment

Form WWC-5