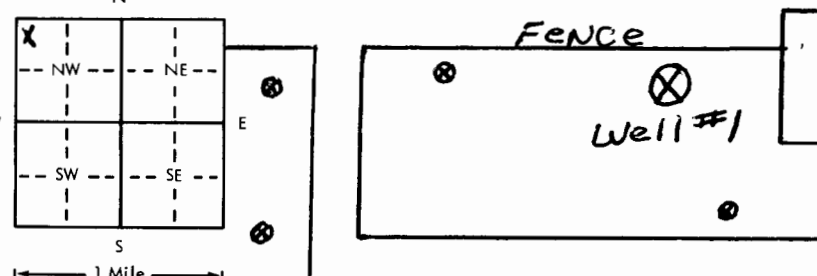


USE TYPEWRITER OR BALL
POINT PEN-PRESS FIRMLY,
PRINT CLEARLY.

WATER WELL RECORD
KSA 82a-1201-1215

Kansas Department of Health and
Environment-Division of Environment
(Water well Contractors)
Topeka, Kansas 66620

1. Location of well: <u>SE06W10E</u>		County: <u>SE06W10E</u>	Fraction: <u>NW 1/4 NW 1/4 NW 1/4</u>	Section number: <u>19</u>	Township number: <u>T 26 S</u>	Range number: <u>R 26 E E/W</u>
2. Distance and direction from nearest town or city: Street address of well location if in city: <u>5320 N Meridian</u>			3. Owner of well: <u>Big O Oil Co.</u> R.R. or street: <u>2614 N. MARKET</u> City, state, zip code: <u>WICHITA, KS.</u>			
4. Locate with "X" in section below: N W E S 1 Mile		Sketch map: 		6. Bore hole dia. <u>14</u> in. Completion date <u>6-7-78</u> Well depth <u>16</u> ft.		
5. Type and color of material		From To		7. Cable tool <input type="checkbox"/> Rotary <input type="checkbox"/> Driven <input type="checkbox"/> Dug <input type="checkbox"/> <input type="checkbox"/> Hollow rod <input type="checkbox"/> Jetted <input checked="" type="checkbox"/> Bored <input type="checkbox"/> Reverse rotary		
				8. Use: Domestic <input type="checkbox"/> Public supply <input type="checkbox"/> Industry <input type="checkbox"/> Irrigation <input type="checkbox"/> Air conditioning <input type="checkbox"/> Stock <input type="checkbox"/> Lawn <input type="checkbox"/> Oil field water <input checked="" type="checkbox"/> Other		
				9. Casing: Material <u>PVC</u> Height: Above or below Threaded <input type="checkbox"/> Welded <input type="checkbox"/> Surface <u>12</u> in. RMP <input type="checkbox"/> PVC <input checked="" type="checkbox"/> Weight <u>2750</u> lbs./ft. Dia. <u>5</u> in. to <u> </u> ft. depth Wall Thickness: inches or Dia. <u> </u> in. to <u> </u> ft. depth gage No. <u>258</u>		
				10. Screens: Manufacturer's name <u>Modern Pipe Co.</u> Type <u>PVC</u> Dia. <u>5.563</u> Slot/gauze <u>.025</u> Length <u>5</u> Set between <u>10</u> ft. and <u>15</u> ft. <u> </u> ft. and <u> </u> ft. Gravel pack? <u>No</u> Size range of material <u> </u>		
				11. Static water level: <u>10</u> ft. below land surface Date <u> </u> mo./day/yr.		
(Use a second sheet if needed)				12. Pumping level below land surfaces: <u>17</u> ft. after <u>1</u> hrs. pumping <u>10</u> g.p.m. <u> </u> ft. after <u> </u> hrs. pumping <u> </u> g.p.m. Estimated maximum yield <u> </u> g.p.m.		
				13. Water sample submitted: <u> </u> mo./day/yr. <u> </u> Yes <input checked="" type="checkbox"/> No <input type="checkbox"/> Date <u> </u>		
				14. Well head completion: <u> </u> Pitless adapter <u>12</u> inches above grade		
				15. Well grouted? <u>yes</u> With: <input checked="" type="checkbox"/> Neat cement <input type="checkbox"/> Bentonite <input type="checkbox"/> Concrete <input type="checkbox"/> Depth: From <u>0</u> ft. to <u>10</u> ft.		
				16. Nearest source of possible contamination: ft. <u>40</u> Direction <u>W</u> Type <u>gas tank</u> Well disinfected upon completion? <input checked="" type="checkbox"/> Yes <input type="checkbox"/> No		
(Use a second sheet if needed)				17. Pump: <input checked="" type="checkbox"/> Not installed Manufacturer's name <u> </u> Model number <u> </u> HP <u> </u> Volts <u> </u> Length of drop pipe <u> </u> ft. capacity <u> </u> g.p.m. Type: <input type="checkbox"/> Submersible <input type="checkbox"/> Turbine <input type="checkbox"/> Jet <input type="checkbox"/> Reciprocating <input type="checkbox"/> Centrifugal <input type="checkbox"/> Other		
				20. Water well contractor's certification: This well was drilled under my jurisdiction and this report is true to the best of my knowledge and belief. <u>2151 Leathers Co.</u> 129 Business name <u>512 W. 21st</u> License No. <u> </u> Address <u> </u> Signed <u>J. Harris</u> Date <u>6-12-78</u> Authorized representative		
				18. Elevation: <u> </u>		
				19. Remarks: <u>Test well</u>		
				Topography: <input type="checkbox"/> Hill <input type="checkbox"/> Slope <input type="checkbox"/> Upland <input checked="" type="checkbox"/> Valley		

Forward the white, blue and pink copies to the Department of Health and Environment

Form WWC-5