

|   |   |                             |                                  |                                      |
|---|---|-----------------------------|----------------------------------|--------------------------------------|
| 1 LOCATION OF WATER WELL:<br>County: <u>Adair</u> | Fraction<br><u>SW</u> $\frac{1}{4}$ <u>SW</u> $\frac{1}{4}$ <u>NW</u> $\frac{1}{4}$ | Section Number<br><u>20</u> | Township Number<br>T <u>26</u> S | Range Number<br>R <u>1</u> <u>EN</u> |
|---|---|-----------------------------|----------------------------------|--------------------------------------|

Distance and direction from nearest town or city street address of well if located within city?

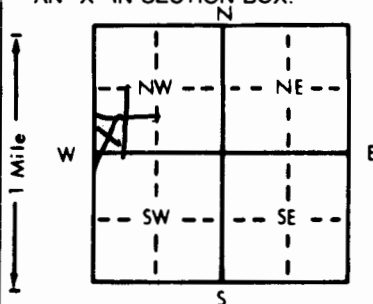
5030 - Seneca

2 WATER WELL OWNER: Mr. Raider  
 RR#, St. Address, Box #: 5030 - Seneca  
 City, State, ZIP Code: Wichita Kan 67204

Board of Agriculture, Division of Water Resources

Application Number: none

3 LOCATE WELL'S LOCATION WITH AN "X" IN SECTION BOX:


WELL WATER TO BE USED AS: 5 Public water supply 8 Air conditioning 11 Injection well

1 Domestic 3 Feedlot 6 Oil field water supply 9 Dewatering 12 Other (Specify below)

2 Irrigation 4 Industrial 7 Lawn and garden only 10 Monitoring well

Was a chemical/bacteriological sample submitted to Department? Yes X No X; If yes, mo/day/yr sample was submittedWater Well Disinfected? Yes X No X

5 TYPE OF BLANK CASING USED:

1 Steel 3 RMP (SR)  
2 PVC 4 ABS5 Wrought iron 8 Concrete tile  
6 Asbestos-Cement 9 Other (specify below)CASING JOINTS: Glued X Clamped X  
Welded X  

TYPE OF SCREEN OR PERFORATION MATERIAL:

1 Steel 3 Stainless steel  
2 Brass 4 Galvanized steel5 Fiberglass 8 RMP (SR)  
6 Concrete tile 9 ABS10 Asbestos-cement  
11 Other (specify) 10  
12 None used (open hole)

SCREEN OR PERFORATION OPENINGS ARE:

1 Continuous slot 3 Mill slot  
2 Louvered shutter 4 Key punched5 Gauzed wrapped 8 Saw cut 11 None (open hole)  
6 Wire wrapped 9 Drilled holes  

6 GROUT MATERIAL: 1 Neat cement 2 Cement grout 3 Bentonite 4 Other


What is the nearest source of possible contamination:

1 Septic tank 4 Lateral lines  
2 Sewer lines 5 Cess pool  
3 Watertight sewer lines 6 Seepage pit7 Pit privy  
8 Sewage lagoon  
9 Feedyard10 Livestock pens 14 Abandoned water well  
11 Fuel storage 15 Oil well/Gas well  
12 Fertilizer storage 16 Other (specify below)  
13 Insecticide storage

Direction from well?

EHow many feet? 60

FROM TO LITHOLOGIC LOG FROM TO PLUGGING INTERVALS

|    |    |   |  |  |  |
|----|----|---|--|--|--|
| 8  | 6  | <u>Top Soil</u><br><u>Fine Tan Sand</u><br><u>Coarse Tan Sand</u> |  |  |  |
| 6  | 19 |   |  |  |  |
| 19 | 39 |   |  |  |  |

7 CONTRACTOR'S OR LANDOWNER'S CERTIFICATION: This water well was (1) constructed (2) reconstructed, or (3) plugged under my jurisdiction and was completed on (mo/day/year) 6-11-91 and this record is true to the best of my knowledge and belief. KansasWater Well Contractor's License No. 472 This Water Well Record was completed on (mo/day/yr) 6-11-91  
under the business name of Beardon Pump & Well Dr. by (signature) David R. Beardon