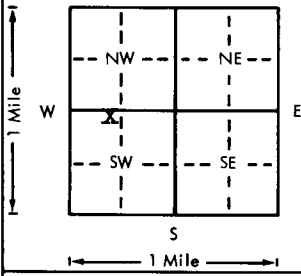


USE TYPEWRITER OR BALL
POINT PEN-PRESS FIRMLY,
PRINT CLEARLY.

WATER WELL RECORD
KSA 82a-1201-1215

Kansas Department of Health and
Environment-Division of Environment
(Water well Contractors)
Topeka, Kansas 66620

1. Location of well:		County Sedgwick	Fraction SW NW NE SW NE 1/4 SW 1/4 SE 1/4	Section number 20	Township number T 26 S	Range number R 1E E/W
2. Distance and direction from nearest town or city: Street address of well location if in city:			3. Owner of well: Don Hale R.R. or street: 835 Ryder Lane City, state, zip code: Wichita, Kansas			
4. Locate with "X" in section below:		Sketch map:		6. Bore hole dia. 11 in. Completion date 4-12-77 Well depth 45 ft.		
				7. <input checked="" type="checkbox"/> Cable tool <input checked="" type="checkbox"/> Rotary <input type="checkbox"/> Driven <input type="checkbox"/> Dug <input type="checkbox"/> Hollow rod <input type="checkbox"/> Jetted <input type="checkbox"/> Bored <input type="checkbox"/> Reverse rotary		
5. Type and color of material		From	To	8. Use: <input type="checkbox"/> Domestic <input type="checkbox"/> Public supply <input type="checkbox"/> Industry <input type="checkbox"/> Irrigation <input type="checkbox"/> Air conditioning <input type="checkbox"/> Stock <input checked="" type="checkbox"/> Lawn <input type="checkbox"/> Oil field water <input type="checkbox"/> Other		
Topsoil		0	3	9. Casing: Material Styrene Height: Above or below /// Threaded <input type="checkbox"/> Welded <input checked="" type="checkbox"/> Surface 12 in. RMP <input checked="" type="checkbox"/> PVC <input type="checkbox"/> Weight <input type="checkbox"/> lbs./ft. Dia. 5 in. to 45 ft. depth Wall Thickness: inches or Dia. <input type="checkbox"/> in. to <input type="checkbox"/> ft. depth gage No. 200		
Clay		3	10	10. Screen Manufacturer's name Sunflower Plastic Type Styrene Dia. 5" Slot/gage /// 06 Length 10' Set between 35 ft. and 45 ft. ft. and 4-1/8" Gravel pack? yes Size range of material		
Fine Sand		10	25	11. Static water level: 15 ft. below land surface Date 4-12-77 mo./day/yr.		
Medium Sand		25	45	12. Pumping level below land surfaces: ft. after hrs. pumping g.p.m. ft. after hrs. pumping g.p.m. Estimated maximum yield g.p.m.		
				13. Water sample submitted: mo./day/yr. Yes No Date		
				14. Well head completion: capped Pitless adapter 12 Inches above grade		
				15. Well grouted? yes With: 40" 14 Bentonite <input checked="" type="checkbox"/> Concrete Depth: From 40" ft. to 14 ft.		
				16. Nearest source of possible contamination: Septic Tank ft. 30 Direction West Type Tank Well disinfected upon completion? <input checked="" type="checkbox"/> Yes <input type="checkbox"/> No		
				17. Pump: <input checked="" type="checkbox"/> Not installed Manufacturer's name Model number HP Volts Length of drop pipe ft. capacity g.p.m. Type: <input type="checkbox"/> Submersible <input type="checkbox"/> Turbine <input type="checkbox"/> Jet <input type="checkbox"/> Reciprocating <input type="checkbox"/> Centrifugal <input type="checkbox"/> Other		
		(Use a second sheet if needed)		20. Water well contractor's certification: This well was drilled under my jurisdiction and this report is true to the best of my knowledge and belief. Harp Well & Pump 236 Business name License No. Address Wichita, Kansas Signed M. Arnold Date 4-18-77 Authorized representative		
18. Elevation:		19. Remarks:				
Topography: <input type="checkbox"/> Hill <input type="checkbox"/> Slope <input type="checkbox"/> Upland <input checked="" type="checkbox"/> Valley						

Forward the white, blue and pink copies to the Department of Health and Environment

Form WWC-5