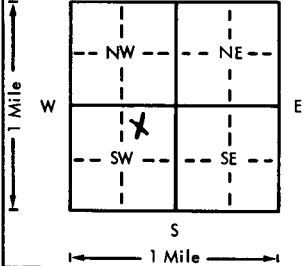


USE TYPEWRITER OR BALL
POINT PEN-PRESS FIRMLY,
PRINT CLEARLY.

WATER WELL RECORD
KSA 82a-1201-1215

Kansas Department of Health and
Environment-Division of Environment
(Water well Contractors)
Topeka, Kansas 66620

1. Location of well:		County Sedgwick	Fraction NW 1/4 NE 1/4 SW 1/4	Section number 20	Township number T 26 S	Range number R 1 E
2. Distance and direction from nearest town or city: Street address of well location if in city:			3. Owner of well: Don Clark R.R. or street: 4812 Armstrong City, state, zip code: Wichita, Kansas			
4. Locate with "X" in section below:		Sketch map:		6. Bore hole dia. 11 in. Completion date 12-9-76 Well depth 45 ft.		
				7. <input checked="" type="checkbox"/> Cable tool <input checked="" type="checkbox"/> Rotary <input type="checkbox"/> Driven <input type="checkbox"/> Dug <input type="checkbox"/> Hollow rod <input type="checkbox"/> Jetted <input type="checkbox"/> Bored <input type="checkbox"/> Reverse rotary		
5. Type and color of material		From		To		8. Use: <input checked="" type="checkbox"/> Domestic <input type="checkbox"/> Public supply <input type="checkbox"/> Industry <input type="checkbox"/> Irrigation <input type="checkbox"/> Air conditioning <input type="checkbox"/> Stock <input type="checkbox"/> Lawn <input type="checkbox"/> Oil field water <input type="checkbox"/> Other
Sandy Topsoil		0		2		9. Casing: Material styrene Height: Above or below 11 Threaded <input type="checkbox"/> Welded <input checked="" type="checkbox"/> Surface 12 in. RMP <input checked="" type="checkbox"/> PVC <input type="checkbox"/> Weight <input type="checkbox"/> lbs./ft. Dia. 5 in. to 45 ft. depth Wall Thickness: inches or Dia. <input type="checkbox"/> in. to <input type="checkbox"/> ft. depth Gage No. .200
Fine Sand		2		15		10. Screens: Manufacturer's name Sunflower Plastic Type styrene Dia. 5" Slot/size .06 Length 10' Set between 35 ft. and 45 ft. Gravel pack? yes Size range of material 1/8-1/4"
Medium Sand		15		45		11. Static water level: 15 ft. below land surface Date 12-9-76 mo./day/yr.
						12. Pumping level below land surfaces: _____ ft. after _____ hrs. pumping _____ g.p.m. _____ ft. after _____ hrs. pumping _____ g.p.m. Estimated maximum yield _____ g.p.m.
						13. Water sample submitted: _____ mo./day/yr. Yes <input type="checkbox"/> No <input type="checkbox"/> Date _____
						14. Well head completion: 12 capped _____ Pitless adapter _____ Inches above grade
						15. Well grouted? yes With: _____ Neat cement _____ Bentonite <input checked="" type="checkbox"/> Concrete Depth: From 40' ft. to 14' ft.
						16. Nearest source of possible contamination: NONE ft. _____ Direction _____ Type _____ Well disinfected upon completion? <input checked="" type="checkbox"/> Yes <input type="checkbox"/> No
						17. Pump: <input checked="" type="checkbox"/> Not installed Manufacturer's name _____ Model number _____ HP _____ Volts _____ Length of drop pipe _____ ft. capacity _____ g.p.m. Type: _____ Submersible _____ Turbine _____ Jet _____ Reciprocating _____ Centrifugal _____ Other _____
						18. Elevation:
						19. Remarks: Septic Tank not installed when the well was drilled. No apparent source for contamination.
						20. Water well contractor's certification: This well was drilled under my jurisdiction and this report is true to the best of my knowledge and belief. Harp Well & Pump 236 Business name License No. Address Wichita, Kansas Signed M. Arnold Date 12-16-76 Authorized representative

Forward the white, blue and pink copies to the Department of Health and Environment

Form WWC-5