


1 LOCATION OF WATER WELL: Fraction NW 1/4 NE 1/4 Section Number 27-26-15 Township Number 9S Range Number 1E  
County: Sedgwick Distance and direction from nearest town or city street address of well if located within city?

2 WATER WELL OWNER: LOYAL TABBS  
RR#, St. Address, Box #: 3837 N Hillside Board of Agriculture, Division of Water Resources  
City, State, ZIP Code: Wichita KS 67219 Application Number:

3 LOCATE WELL'S LOCATION WITH AN "X" IN SECTION BOX: 4 DEPTH OF COMPLETED WELL: 65 ft. ELEVATION:

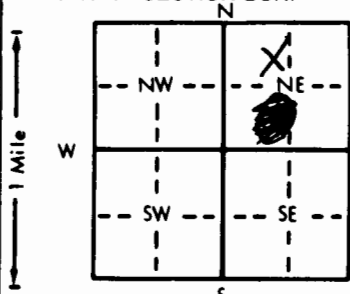

Depth(s) Groundwater Encountered 1. .ft. 2. .ft. 3. .ft.

WELL'S STATIC WATER LEVEL .ft. below land surface measured on mo/day/yr 11/2/89

Pump test data: Well water was .ft. after . hours pumping . gpm

Est. Yield . gpm: Well water was .ft. after . hours pumping . gpm

Bore Hole Diameter . in. to .ft., and . in. to .ft.

WELL WATER TO BE USED AS: 5 Public water supply 8 Air conditioning 11 Injection well

1 Domestic was 3 Feedlot 6 Oil field water supply 9 Dewatering 12 Other (Specify below)

2 Irrigation 4 Industrial 7 Lawn and garden only 10 Monitoring well

Was a chemical/bacteriological sample submitted to Department? Yes . No . If yes, mo/day/yr sample was submitted

Water Well Disinfected? Yes . No .

5 TYPE OF BLANK CASING USED: 5 Wrought iron 8 Concrete tile CASING JOINTS: Glued . Clamped .

1 Steel 3 RMP (SR) 6 Asbestos-Cement 9 Other (specify below) Welded .

2 PVC 4 ABS 7 Fiberglass Threaded .

Blank casing diameter 16 in. to .ft., Dia . in. to .ft., Dia . in. to .ft.

Casing height above land surface 3 below in., weight . lbs./ft. Wall thickness or gauge No. .

TYPE OF SCREEN OR PERFORATION MATERIAL: 7 PVC 10 Asbestos-cement

1 Steel 3 Stainless steel 5 Fiberglass 8 RMP (SR) 11 Other (specify) .

2 Brass 4 Galvanized steel 6 Concrete tile 9 ABS 12 None used (open hole)

SCREEN OR PERFORATION OPENINGS ARE: 5 Gauzed wrapped 8 Saw cut 11 None (open hole)

1 Continuous slot 3 Mill slot 6 Wire wrapped 9 Drilled holes

2 Louvered shutter 4 Key punched 7 Torch cut 10 Other (specify) .

SCREEN-PERFORATED INTERVALS: From .ft. to .ft., From .ft. to .ft.

From .ft. to .ft., From .ft. to .ft.

GRAVEL PACK INTERVALS: From .ft. to .ft., From .ft. to .ft.

From .ft. to .ft., From .ft. to .ft.

6 GROUT MATERIAL: 1 Neat cement 2 Cement grout 3 Bentonite 4 Other .

Grout Intervals: From 3 ft. to 2 ft., From .ft. to .ft., From .ft. to .ft.

What is the nearest source of possible contamination: 10 Livestock pens 14 Abandoned water well

1 Septic tank 4 Lateral lines 7 Pit privy 11 Fuel storage 15 Oil well/Gas well

2 Sewer lines 5 Cess pool 8 Sewage lagoon 12 Fertilizer storage 16 Other (specify below)

3 Watertight sewer lines 6 Seepage pit 9 Feedyard 13 Insecticide storage

Direction from well? SOUTH WEST How many feet? 65

FROM TO LITHOLOGIC LOG FROM TO PLUGGING INTERVALS

65 17 SAND & GRAVEL FROM TO

16 3 Clays FROM TO

3 0 CEMENT FROM TO



7 CONTRACTOR'S OR LANDOWNER'S CERTIFICATION: This water well was (1) constructed, (2) reconstructed, or (3) plugged under my jurisdiction and was completed on (mo/day/year) 11-2-89 and this record is true to the best of my knowledge and belief. Kansas

Water Well Contractor's License No. . This Water Well Record was completed on (mo/day/yr) 11-2-89

under the business name of . by (signature) Jane L. Tabbs

INSTRUCTIONS: Use typewriter or ball point pen. PLEASE PRESS FIRMLY and PRINT clearly. Please fill in blanks, underline or circle the correct answers. Send top three copies to Kansas Department of Health and Environment, Bureau of Water Protection, Topeka, Kansas 66620-7320. Telephone: 913-296-5514. Send one to WATER WELL OWNER and retain one for your records.