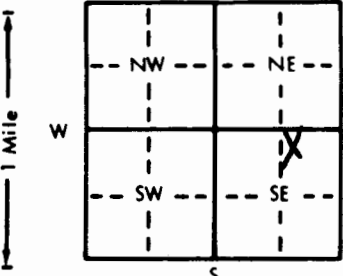


1 LOCATION OF WATER WELL:		Fraction		Section Number		Township Number		Range Number	
County: Sedgwick		NW 1/4 NE 1/4 SE 1/4		28		T 26 S		R 1 EW	
Distance and direction from nearest town or city street address of well if located within city?									
3900 N Bridgeport Wichita									
2 WATER WELL OWNER:		City of Wichita							
RR#, St. Address, Box # :		1900 East 9th Street							
City, State, ZIP Code :		Wichita KS 67214							
3 LOCATE WELL'S LOCATION WITH AN "X" IN SECTION BOX:		4 DEPTH OF COMPLETED WELL... 50.0' ft. ELEVATION: N.A.							
		Depth(s) Groundwater Encountered 1... 26' ft. 2... ft. 3... ft.							
		WELL'S STATIC WATER LEVEL N.A. ft. below land surface measured on mo/day/yr							
		Pump test data: Well water was ft. after hours pumping gpm							
		Est. Yield gpm: Well water was ft. after hours pumping gpm							
Bore Hole Diameter... 8" in. to ft., and in. to ft.		WELL WATER TO BE USED AS:							
1 Domestic		3 Feedlot		6 Oil field water supply		8 Air conditioning		11 Injection well	
2 Irrigation		4 Industrial		7 Lawn and garden only		9 Dewatering		12 Other (Specify below)	
10 Monitoring well									
Was a chemical/bacteriological sample submitted to Department? Yes... No... X...; If yes, mo/day/yr sample was submitted									
Water Well Disinfected? Yes No X									
5 TYPE OF BLANK CASING USED:		5 Wrought iron 8 Concrete tile CASING JOINTS: Glued Clamped							
1 Steel		3 RMP (SR)		6 Asbestos-Cement		9 Other (specify below)		Welded	
2 PVC		4 ABS		7 Fiberglass				Threaded Flush Joint	
Blank casing diameter 2" in. to ft., Dia		in. to ft., Dia							
Casing height above land surface approx 30" in., weight 703 lbs./ft.		Wall thickness or gauge No. 154							
TYPE OF SCREEN OR PERFORATION MATERIAL:		7 PVC 10 Asbestos-cement							
1 Steel		3 Stainless steel		5 Fiberglass		8 RMP (SR)		11 Other (specify)	
2 Brass		4 Galvanized steel		6 Concrete tile		9 ABS		12 None used (open hole)	
SCREEN OR PERFORATION OPENINGS ARE:		5 Gauzed wrapped 8 Saw cut 11 None (open hole)							
1 Continuous slot		3 Mill slot		6 Wire wrapped		9 Drilled holes			
2 Louvered shutter		4 Key punched		7 Torch cut		10 Other (specify)			
SCREEN-PERFORATED INTERVALS:		From 10.0 ft. to 45.5 ft., From ft. to ft.							
GRAVEL PACK INTERVALS:		From 8.0 ft. to 45.5 ft., From ft. to ft.							
6 GROUT MATERIAL:		1 Neat cement 2 Cement grout 3 Bentonite 4 Other							
Grout Intervals: From 8.0 ft. to 1.0 ft., From ft. to ft., From ft. to ft.									
What is the nearest source of possible contamination:		10 Livestock pens 14 Abandoned water well							
1 Septic tank		4 Lateral lines		7 Pit privy		11 Fuel storage		15 Oil well/Gas well	
2 Sewer lines		5 Cess pool		8 Sewage lagoon		12 Fertilizer storage		16 Other (specify below)	
3 Watertight sewer lines		6 Seepage pit		9 Feedyard		13 Insecticide storage		NONE	
Direction from well?		How many feet?							
FROM TO LITHOLOGIC LOG		FROM TO PLUGGING INTERVALS							
0.0' 2.0' Clay, Fill material.									
2.0' 8.0' Silty clay.									
8.0' 36.0' Clay, some silt & sand.									
26.0' 50.0' Sand.									
7 CONTRACTOR'S OR LANDOWNER'S CERTIFICATION: This water well was (1) constructed, (2) reconstructed, or (3) plugged under my jurisdiction and was completed on (mo/day/year) 3-10-92 and this record is true to the best of my knowledge and belief. Kansas Water Well Contractor's License No. 531 This Water Well Record was completed on (mo/day/yr) 4-8-92 under the business name of Geotechnical Services, Inc. by (signature) Allison Irwin									
INSTRUCTIONS: Use typewriter or ball point pen. PLEASE PRESS FIRMLY and PRINT clearly. Please fill in blanks, underline or circle the correct answers. Send top three copies to Kansas Department of Health and Environment, Bureau of Water, Topeka, Kansas 66620-0001. Telephone: 913-296-5545. Send one to WATER WELL OWNER and retain one for your records.									

OFFICE USE ONLY

T

R

EW

SEC

1/4

1/4

1/4