

NE SE SW NE

WATER WELL RECORD

Form WWC-5


KSA 82a-1212

1 LOCATION OF WATER WELL:	Section	Section Number	Township Number	Range Number
County: <u>SEDGWICK</u>	<u>12 1/4</u>	<u>29</u>	T <u>26</u> S	R <u>1</u> E

Distance and direction from nearest town or city street address of well if located within city?

2 WATER WELL OWNER:	Board of Agriculture, Division of Water Resources
RR#, St. Address, Box #:	Application Number:
City, State, ZIP Code:	

3 LOCATE WELL'S LOCATION WITH AN "X" IN SECTION BOX:	4 DEPTH OF COMPLETED WELL: <u>25</u> ft. ELEVATION:
------------------------------------------------------	-----------------------------------------------------

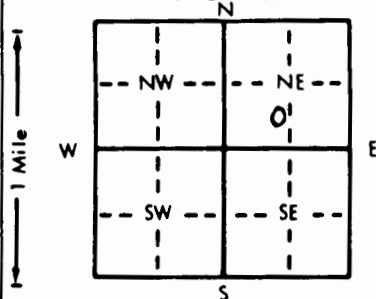

Depth(s) Groundwater Encountered 1. .... ft. 2. .... ft. 3. .... ft.

WELL'S STATIC WATER LEVEL 21 ft. below land surface measured on mo/day/yr

Pump test data: Well water was .... ft. after .... hours pumping .... gpm

Est. Yield .... gpm: Well water was .... ft. after .... hours pumping .... gpm

Bore Hole Diameter .... in. to .... ft. and .... in. to .... ft.

WELL WATER TO BE USED AS: 5 Public water supply 8 Air conditioning 11 Injection well

1 Domestic 3 Feedlot 6 Oil field water supply 9 Dewatering 12 Other (Specify below)

2 Irrigation 4 Industrial 7 Lawn and garden only 10 Monitoring well

Was a chemical/bacteriological sample submitted to Department? Yes ..... No ..... If yes, mo/day/yr sample was sub-

mitted Water Well Disinfected? Yes ✓ No

5 TYPE OF BLANK CASING USED:	5 Wrought iron	8 Concrete tile	CASING JOINTS: Glued ..... Clamped .....
------------------------------	----------------	-----------------	------------------------------------------

1 Steel 3 RMP (SR) 6 Asbestos-Cement 9 Other (specify below) Welded .....

2 PVC 4 ABS 7 Fiberglass Threaded .....

Blank casing diameter 2 1/4 in. to .... ft., Dia. .... in. to .... ft., Dia. .... in. to .... ft.Casing height above land surface 80 in., weight .... lbs./ft. Wall thickness or gauge No. ....

TYPE OF SCREEN OR PERFORATION MATERIAL: 7 PVC 10 Asbestos-cement

1 Steel 3 Stainless steel 5 Fiberglass 8 RMP (SR) 11 Other (specify) 999

2 Brass 4 Galvanized steel 6 Concrete tile 9 ABS 12 None used (open hole)

SCREEN OR PERFORATION OPENINGS ARE: 5 Gauzed wrapped 8 Saw cut 11 None (open hole)

1 Continuous slot 3 Mill slot 6 Wire wrapped 9 Drilled holes 9992 Louvered shutter 4 Key punched 7 Torch cut 10 Other (specify) 999SCREEN-PERFORATED INTERVALS: From 999 ft. to 999 ft., From .... ft. to .... ft.

From .... ft. to .... ft., From .... ft. to .... ft.

GRAVEL PACK INTERVALS: From .... ft. to .... ft., From .... ft. to .... ft.

From .... ft. to .... ft., From .... ft. to .... ft.

6 GROUT MATERIAL:	1 Neat cement	2 Cement grout	3 Bentonite	4 Other
-------------------	---------------	----------------	-------------	---------

Grout Intervals: From 25 ft. to 3 ft., From .... ft. to .... ft., From .... ft. to .... ft.

What is the nearest source of possible contamination: 10 Livestock pens 14 Abandoned water well

1 Septic tank 4 Lateral lines 7 Pit privy 11 Fuel storage 15 Oil well/Gas well

2 Sewer lines 5 Cess pool 8 Sewage lagoon 12 Fertilizer storage 16 Other (specify below)

3 Watertight sewer lines 6 Seepage pit 9 Feedyard 13 Insecticide storage NOTE

Direction from well? How many feet?

FROM	TO	LITHOLOGIC LOG	FROM	TO	PLUGGING INTERVALS
------	----	----------------	------	----	--------------------

25 3 CEMENT