


USE TYPEWRITER OR BALL
POINT PEN-PRESS FIRMLY,
PRINT CLEARLY.


WATER WELL RECORD
KSA 82a-1201-1215

T R EW sec 1/4 1/4 1/4 No.

Kansas State Dept. Of Health
(Water Well Contractors)
Forbes-Bldg. 740
Topeka, Kansas 66620

BILLED TO: GOOLSBY PLUMBING NW NW SW SE

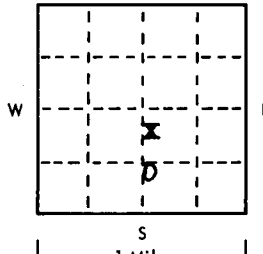1 Location of well:	County Sedgwick	Township name Kechi	Fraction NW 1/4 SE 1/4	Section number 29	Town number 26S	Range number 1E
Distance and direction from nearest town or city: 3920 No. Arkansas Street address of well location if in city: Wichita, Kansas			3 Owner of well: Temple Dial Building Address: 3920 North Arkansas Wichita, Kansas			
Locate with "X" in section below: 			Sketch map: 4 Well depth: 46 ft. Date of completion 6-27-75 Well diameter 12 in. 5 <input type="checkbox"/> Cable tool <input checked="" type="checkbox"/> Rotary <input type="checkbox"/> Driven <input type="checkbox"/> Dug <input type="checkbox"/> Hollow rod <input type="checkbox"/> Jetted <input type="checkbox"/> Bored <input type="checkbox"/> Reverse rotary 6 Use: <input checked="" type="checkbox"/> Domestic <input type="checkbox"/> Public supply <input type="checkbox"/> Industry <input type="checkbox"/> Irrigation <input type="checkbox"/> Air conditioning <input type="checkbox"/> Commercial <input type="checkbox"/> Test well <input checked="" type="checkbox"/> Rest Rooms 7 Casing: Material Styrene <input type="checkbox"/> Above <input checked="" type="checkbox"/> Below <input type="checkbox"/> Threaded <input type="checkbox"/> Welded <input type="checkbox"/> Surface 12 in. Diam. 5 in. to 46 ft. depth Weight 12 lbs./ft. <input type="checkbox"/> Drive shoe? <input type="checkbox"/> Yes <input type="checkbox"/> No <input type="checkbox"/> in. to ft. depth			
2 Type and color of material			From	To	8 Screen: Manufacturer Sunflower Type styrene Dia. 6" Slot/gauze .007 Length 10' Set between 36 ft. and 46 ft. Fittings: Gravel pack <input checked="" type="checkbox"/> Yes <input type="checkbox"/> No Size range of material 1/2-1/8"	
Sandy Soil			0	2	9 Static water level: 15 ft. below land surface Date 6-27-75	
Fine Sand			2	20	10 Pumping level below land surfaces: ____ ft. after ____ hrs. pumping ____ g.p.m. ____ ft. after ____ hrs. pumping ____ g.p.m. Estimated maximum yield ____ g.p.m.	
Medium Coarse Sand			20	30	11 Water sample submitted: <input type="checkbox"/> Yes <input type="checkbox"/> No Date ____	
Coarse Sand and fine Gravel			30	46	12 Well head completion: <input checked="" type="checkbox"/> Pitless adapter 12 <input checked="" type="checkbox"/> Inches above grade	
					13 Well grouted? <input checked="" type="checkbox"/> Yes <input type="checkbox"/> No <input checked="" type="checkbox"/> Neat cement <input type="checkbox"/> Bentonite <input type="checkbox"/> Depth: From 0 ft. to 10 ft.	
					14 Nearest source of possible contamination: ft. 55 Direction North Type Septic tank Well disinfected upon completion? <input checked="" type="checkbox"/> Yes <input type="checkbox"/> No	
					15 Pump: <input type="checkbox"/> Not installed Manufacturer's name Sta-Rite Model number LP6D2 HP 3/4 Volts 230 Length of drop pipe 25 ft. capacity ____ g.p.m. Type: <input checked="" type="checkbox"/> Submersible <input type="checkbox"/> Turbine <input type="checkbox"/> Jet <input type="checkbox"/> Reciprocating <input type="checkbox"/> Centrifugal <input type="checkbox"/> Other	
16 Remarks: elevation			17 Water well contractor's certification: This well was drilled under my jurisdiction and this report is true to the best of my knowledge and belief. Harp Well & Pump 236 Business name Wichita, Kansas License No. 67209 Address 777 N. Ornell Date 6-28-75 Signed A. Ornell Authorized representative			

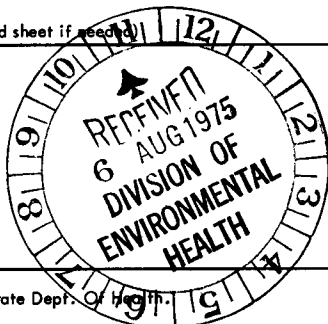

Forward the white, blue and pink copies to the Kansas State Dept. Of Health.

Form WWC-5