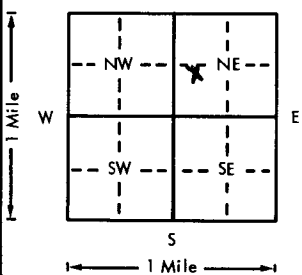


USE TYPEWRITER OR BALL
POINT PEN-PRESS FIRMLY,
PRINT CLEARLY.

WATER WELL RECORD
KSA 82a-1201-1215

Kansas Department of Health and
Environment-Division of Environment
(Water well Contractors)
Topeka, Kansas 66620

1. Location of well:		County Sedgwick	Fraction SE NE 1/4 SW 1/4 NE 1/4	Section number 29	Township number T 26 S	Range number R 1E E/W
2. Distance and direction from nearest town or city: Street address of well location if in city: 301 Long Lane Road Wichita, Kansas			3. Owner of well: Gary Belshe R.R. or street: 301 Long Lane Road City, state, zip code: Wichita, Kansas			
4. Locate with "X" in section below: N W E S 1 Mile 1 Mile			Sketch map: 		6. Bore hole dia. 11 in. Completion date 10-25-77 Well depth 40 ft.	
5. Type and color of material			From	To	7. Cable tool <input checked="" type="checkbox"/> Rotary <input type="checkbox"/> Driven <input type="checkbox"/> Dug <input type="checkbox"/> Hollow rod <input type="checkbox"/> Jetted <input type="checkbox"/> Bored <input type="checkbox"/> Reverse rotary	
Sandy Topsoil			0	2	8. Use: <input checked="" type="checkbox"/> Domestic <input type="checkbox"/> Public supply <input type="checkbox"/> Industry <input type="checkbox"/> Irrigation <input type="checkbox"/> Air conditioning <input type="checkbox"/> Stock <input type="checkbox"/> Lawn <input type="checkbox"/> Oil field water <input type="checkbox"/> Other	
Sand (Dirty)			2	15	9. Casing: Material styrene Height: Above or below 111 Threaded <input type="checkbox"/> Welded <input checked="" type="checkbox"/> Surface 12 in. RMP <input checked="" type="checkbox"/> PVC 40 Weight 10 lbs./ft. Dia. 5 in. to 40 ft. depth Wall Thickness: inches or Dia. 5 in. to 40 ft. depth gage No. .200	
Medium Sand (Clean)			15	25	10. Screen: Manufacturer's name Sunflower Plastic Type Styrene Dia. 5 in. Slot/gauge .06 Length 10' Set between 30 ft. and 40 ft. Gravel pack? yes Size range of material 1/4-1/8 ft.	
Coarse Sand			25	40	11. Static water level: 16 ft. below land surface Date 10-25-77 mo./day/yr.	
					12. Pumping level below land surfaces: ____ ft. after ____ hrs. pumping ____ g.p.m. ____ ft. after ____ hrs. pumping ____ g.p.m. Estimated maximum yield ____ g.p.m.	
					13. Water sample submitted: ____ mo./day/yr. Yes ____ No ____ Date ____	
					14. Well head completion: 12 capped Pitless adapter ____ inches above grade	
					15. Well grouted? yes 1-2 fine sand mix With: Neat cement ____ Bentonite <input checked="" type="checkbox"/> Concrete ____ Depth: From 40 ft. to 14 ft.	
					16. Nearest source of possible contamination: Septic Tank ft. 90 Direction South Type Tank Well disinfected upon completion? <input checked="" type="checkbox"/> Yes ____ No ____	
					17. Pump: <input checked="" type="checkbox"/> Not installed Manufacturer's name ____ Model number ____ HP ____ Volts ____ Length of drop pipe ____ ft. capacity ____ g.p.m. Type: ____ Submersible ____ Turbine ____ Jet ____ Reciprocating ____ Centrifugal ____ Other ____	
					(Use a second sheet if needed)	
18. Elevation: Topography: ____ Hill ____ Slope ____ Upland ____ Valley		19. Remarks: Flat Ground		20. Water well contractor's certification: This well was drilled under my jurisdiction and this report is true to the best of my knowledge and belief. Harp Well & Pump 236 Business name License No. ____ Address Wichita, Kansas Signed M. Arnold Date 11-4-77 Authorized representative		

Forward the white, blue and pink copies to the Department of Health and Environment

Form WWC-5