


1 LOCATION OF WATER WELL: Fraction SW 1/4 SW 1/4 NW 1/4 Section Number 30 Township Number T 26 S Range Number R 1 E
 County: SEDGWICK
 Distance and direction from nearest town or city street address of well if located within city?
48th + MERIDIAN

2 WATER WELL OWNER: MILE SAND + GRAVEL
 RR#, St. Address, Box #: 48th + MERIDIAN WICHITA KS
 City, State, ZIP Code: WICHITA KS
 Board of Agriculture, Division of Water Resources
 Application Number:

3 LOCATE WELL'S LOCATION WITH AN "X" IN SECTION BOX:

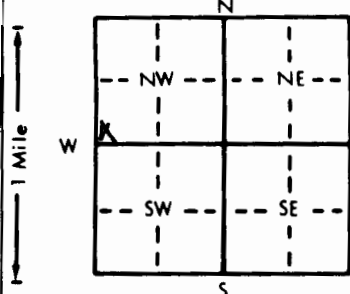

4 DEPTH OF COMPLETED WELL: 20 ft. ELEVATION:

Depth(s) Groundwater Encountered 1. 15 ft. 2. 20 ft. 3. 20 ft.

WELL'S STATIC WATER LEVEL 15 ft. below land surface measured on mo/day/yr




WELL WATER TO BE USED AS: 5 Public water supply 8 Air conditioning 11 Injection well

1 Domestic 3 Feedlot 6 Oil field water supply 9 Dewatering 12 Other (Specify below)

2 Irrigation 4 Industrial 7 Lawn and garden only 10 Monitoring well

Was a chemical/bacteriological sample submitted to Department? Yes No If yes, mo/day/yr sample was submitted

Water Well Disinfected? Yes No

5 TYPE OF BLANK CASING USED: 5 Wrought iron 8 Concrete tile CASING JOINTS: Glued Clamped

1 Steel 3 RMP (SR) 6 Asbestos-Cement 9 Other (specify below) Welded Threaded

2 (PVC) 4 ABS 7 Fiberglass



TYPE OF SCREEN OR PERFORATION MATERIAL: 7 PVC 10 Asbestos-cement

1 Steel 3 Stainless steel 5 Fiberglass 8 RMP (SR) 11 Other (specify)

2 Brass 4 Galvanized steel 6 Concrete tile 9 ABS 12 None used (open hole)

SCREEN OR PERFORATION OPENINGS ARE: 5 Gauzed wrapped 8 Saw cut 11 None (open hole)

1 Continuous slot 3 Mill slot 6 Wire wrapped 9 Drilled holes

2 Louvered shutter 4 Key punched 7 Torch cut 10 Other (specify)







What is the nearest source of possible contamination: 10 Livestock pens 14 Abandoned water well

1 Septic tank 4 Lateral lines 7 Pit privy 11 Fuel storage 15 Oil well/Gas well

2 Sewer lines 5 Cess pool 8 Sewage lagoon 12 Fertilizer storage 16 Other (specify below)

3 Watertight sewer lines 6 Seepage pit 9 Feedyard 13 Insecticide storage SAND PIT

Direction from well? WITHIN SITE How many feet? WITHIN

FROM TO LITHOLOGIC LOG FROM TO PLUGGING INTERVALS

10 TO 10 SANDY CLAY

10 TO 10 SAUD

7 CONTRACTOR'S OR LANDOWNER'S CERTIFICATION: This water well was (1) constructed, (2) reconstructed, or (3) plugged under my jurisdiction and was completed on (mo/day/year) 10/15/92 and this record is true to the best of my knowledge and belief. Kansas Water Well Contractor's License No. 102W This Water Well Record was completed on (mo/day/yr) 10/22/92 under the business name of LAYNE by (signature) Don Layne