WATER WELL RECORD Form WWC-5 KSA 82a-1212

1 LOCATION OF WATER WELL: County: SEDGWICK | Fraction: SE¼ SE¼ SW¼ | Section Number: 30 | Township Number: T 26 S | Range Number: R 1 (E) W

Distance and direction from nearest town or city, street address or well if located within city?
1930 W 37TH CT. NORTH WICHITA KANS

2 WATER WELL OWNER: THOMAS R. UPDEGROVE — WICHITA KANS 67204
RR#, St. Address, Box # : 1930 W 37TH CT. NORTH
City, State, ZIP Code : FROM BASEMENT
Board of Agriculture, Division of Water Resources
Application Number: NONE

3 LOCATE WELL'S LOCATION WITH AN "X" IN SECTION BOX:

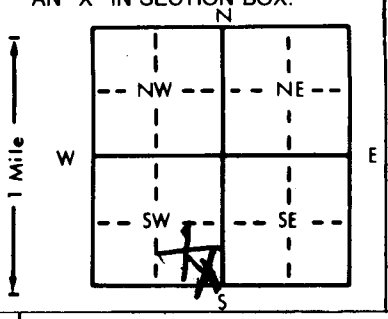

4 DEPTH OF COMPLETED WELL 26.5 ft. ELEVATION: 1300
Depth(s) Groundwater Encountered 1. 5 ft. 2. ft. 3. ft.
WELL'S STATIC WATER LEVEL 5 ft. below land surface measured on mo/day/yr 4/27/83
Pump test data: Well water was NA ft. after NA hours pumping NA gpm
Est. Yield 70 gpm: Well water was 5 ft. after 6 hours pumping 26.5 gpm
Bore Hole Diameter 9 in. to 5 ft., and 6 in. to 26.5 ft.
WELL WATER TO BE USED AS: 5 Public water supply 8 Air conditioning 11 Injection well
1 Domestic 3 Feedlot 6 Oil field water supply 9 Dewatering 12 Other (Specify below)
2 Irrigation 4 Industrial (7) Lawn and garden only 10 Observation well
Was a chemical/bacteriological sample submitted to Department? Yes (No); If yes, mo/day/yr sample was submitted
Water Well Disinfected? Yes (No)

5 TYPE OF BLANK CASING USED: 5 Wrought iron 8 Concrete tile CASING JOINTS: (Glued) Clamped
1 Steel (3) RMP (SR) 6 Asbestos-Cement 9 Other (specify below) Welded
2 PVC 4 ABS 7 Fiberglass Threaded
Blank casing diameter 5 in. to 19.5 ft., Dia in. to ft., Dia in. to ft.
Casing height above land surface 12 in., weight 1.55 lbs./ft. Wall thickness or gauge No. 6209

TYPE OF SCREEN OR PERFORATION MATERIAL: 7 PVC 10 Asbestos-cement
1 Steel 3 Stainless steel 5 Fiberglass (8) RMP (SR) 11 Other (specify)
2 Brass 4 Galvanized steel 6 Concrete tile 9 ABS 12 None used (open hole)

SCREEN OR PERFORATION OPENINGS ARE: 5 Gauzed wrapped (8) Saw cut 11 None (open hole)
1 Continuous slot 3 Mill slot 6 Wire wrapped 9 Drilled holes
2 Louvered shutter 4 Key punched 7 Torch cut 10 Other (specify)

SCREEN-PERFORATED INTERVALS: From 18.5 ft. to 26.5 ft., From ft. to ft.
From ft. to ft., From ft. to ft.
GRAVEL PACK INTERVALS: From NONE ft. to ft., From ft. to ft.
From ft. to ft., From ft. to ft.

6 GROUT MATERIAL: 1 Neat cement (2) Cement grout 3 Bentonite 4 Other
Grout Intervals: From 0 ft. to 5 ft., From ft. to ft., From ft. to ft.

What is the nearest source of possible contamination:
10 Livestock pens 14 Abandoned water well
1 Septic tank 4 Lateral lines 7 Pit privy 11 Fuel storage 15 Oil well/Gas well
2 Sewer lines 5 Cess pool 8 Sewage lagoon 12 Fertilizer storage #1 16 Other (specify below)
3 Watertight sewer lines 6 Seepage pit 9 Feedyard 13 Insecticide storage SUMP PUMPS
Direction from well? #1 SUMP 2½' N #2 SUMP 5' S How many feet? FOUNDATION SUMP 2½

FROM	TO	LITHOLOGIC LOG
0	6	SAND MED - TAN
6	26½	SAND TAN COARSE

FROM	TO	LITHOLOGIC LOG
#2		SUMP W/ CONNECTION TO SINK DRAIN 6 FT.

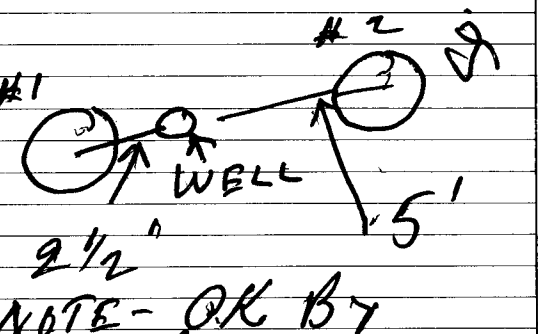

NOTE - OK BY APPEAL

7 CONTRACTOR'S OR LANDOWNER'S CERTIFICATION: This water well was (1) constructed, (2) reconstructed, or (3) plugged under my jurisdiction and was completed on (mo/day/year) 4/27/83 and this record is true to the best of my knowledge and belief. Kansas Water Well Contractor's License No. 104 This Water Well Record was completed on (mo/day/yr) 5/2/83 under the business name of BEARDEN PUMP & WELL by (signature) Otis W Bearden

INSTRUCTIONS: Use typewriter or ball point pen, *PLEASE PRESS FIRMLY* and *PRINT* clearly. Please fill in blanks, underline or circle the correct answers. Send top three copies to Kansas Department of Health and Environment, Division of Environment, Environmental Geology Section, Topeka, KS 66620. Send one to WATER WELL OWNER and retain one for your records.

OFFICE USE ONLY T 26 R 1 (E) W SEC. 30 SE¼ SE¼ SW¼