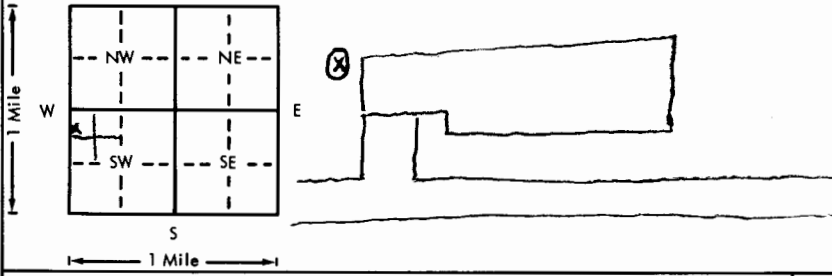


USE TYPEWRITER OR BALL
POINT PEN-PRESS FIRMLY,
PRINT CLEARLY.

WATER WELL RECORD
KSA 82a-1201-1215

Kansas Department of Health and
Environment-Division of Environment
(Water well Contractors)
Topeka, Kansas 66620

1. Location of well:		County <u>Sedgwick</u>	Fraction <u>NW 1/4 NW 1/4 SW 1/4</u>	Section number <u>31</u>	Township number <u>T 26 S R 1</u>	Range number <u>EW</u>
2. Distance and direction from nearest town or city: Street address of well location if in city: <u>3148 N Meridian</u>				3. Owner of well: <u>A. S. ARNOLD</u> R.R. or street: <u>3148 N Meridian</u> City, state, zip code: <u>Wichita Kansas</u>		
4. Locate with "X" in section below:		Sketch map:		6. Bore hole dia. <u>11</u> in. Completion date <u>4-25-78</u> Well depth <u>25</u> ft.		
				7. <input type="checkbox"/> Cable tool <input type="checkbox"/> Rotary <input type="checkbox"/> Driven <input type="checkbox"/> Dug <input type="checkbox"/> Hollow rod <input type="checkbox"/> Jetted <input checked="" type="checkbox"/> Bored <input type="checkbox"/> Reverse rotary		
5. Type and color of material		From	To	8. Use: <input type="checkbox"/> Domestic <input type="checkbox"/> Public supply <input type="checkbox"/> Industry <input type="checkbox"/> Irrigation <input type="checkbox"/> Air conditioning <input type="checkbox"/> Stock <input checked="" type="checkbox"/> Lawn <input type="checkbox"/> Oil field water <input type="checkbox"/> Other		
<u>CLAY</u>		<u>0</u>	<u>5</u>	9. Casing: Material <u>WC</u> Height: <u>above</u> or below Threaded <input type="checkbox"/> Welded <input type="checkbox"/> Surface <u>12</u> in. RMP <input type="checkbox"/> PVC <input checked="" type="checkbox"/> Weight <u>2.758</u> lbs./ft. Dia. <u>5</u> in. to <u>25</u> ft. depth Wall Thickness: inches or Dia. <u>5</u> in. to <u>25</u> ft. depth gage No. <u>258</u>		
<u>SAND</u>		<u>6</u>	<u>15</u>	10. Screen: Manufacturer's name <u>MODERN PIPE CO.</u> Type <u>PVC</u> Dia. <u>5.563</u> Slot/gouze <u>.025</u> Length <u>5'</u> Set between <u>20</u> ft. and <u>25</u> ft. ft. and <u>25</u> ft. Gravel pack? <u>NO</u> Size range of material <u>20-40</u>		
<u>Gravel</u>		<u>15</u>	<u>25</u>	11. Static water level: <u>15</u> ft. below land surface Date <u>4-25-78</u> mo./day/yr.		
				12. Pumping level below land surfaces: <u>15</u> ft. after <u>1</u> hrs. pumping <u>10</u> g.p.m. ft. after <u> </u> hrs. pumping <u> </u> g.p.m. Estimated maximum yield <u>50+</u> g.p.m.		
				13. Water sample submitted: <u> </u> mo./day/yr. Yes <input checked="" type="checkbox"/> No <input type="checkbox"/> Date <u> </u>		
				14. Well head completion: <u> </u> Pitless adapter <u>12</u> inches above grade		
				15. Well grouted? <u>YES</u> With: <u> </u> Neat cement <input checked="" type="checkbox"/> Bentonite <u> </u> Concrete <u> </u> Depth: From <u>0</u> ft. to <u>10</u> ft.		
				16. Nearest source of possible contamination: ft. <u>40</u> Direction <u>SW</u> Type <u>SEWER</u> Well disinfected upon completion? <input checked="" type="checkbox"/> Yes <input type="checkbox"/> No		
				17. Pump: <input checked="" type="checkbox"/> Not installed Manufacturer's name <u> </u> Model number <u> </u> HP <u> </u> Volts <u> </u> Length of drop pipe <u> </u> ft. capacity <u> </u> g.p.m. Type: <u> </u> Submersible <u> </u> Turbine <u> </u> Jet <u> </u> Reciprocating <u> </u> Centrifugal <u> </u> Other		
		(Use a second sheet if needed)				
18. Elevation:		19. Remarks:		20. Water well contractor's certification: This well was drilled under my jurisdiction and this report is true to the best of my knowledge and belief. <u>2151 Electric</u> <u>129</u> Business name <u>Wichita, KS</u> License No. <u> </u> Address <u> </u> Date <u>3-2-78</u> Signed <u>J. Harris</u> Authorized representative		
Topography: <input type="checkbox"/> Hill <input type="checkbox"/> Slope <input type="checkbox"/> Upland <input checked="" type="checkbox"/> Valley						

Forward the white, blue and pink copies to the Department of Health and Environment

Form WWC-5