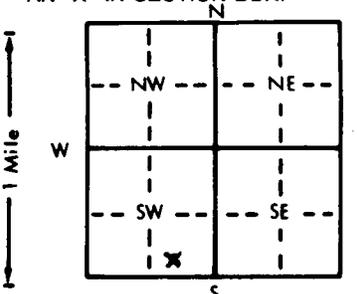


1 LOCATION OF WATER WELL: County: Sedgwick	Fraction SW 1/4 SE 1/4 SW 1/4	Section Number 31	Township Number T 26 S	Range Number R 1 EW
--	----------------------------------	----------------------	---------------------------	-------------------------------

Distance and direction from nearest town or city street address of well if located within city? **N. curb of 29th, 148' to capwell**
Pleasant Valley Elementary, 2000 W. 29th No., Wichita, Ks. 67204 **W. curb of Charles, 124' to capwell**

2 WATER WELL OWNER:
 RR#, St. Address, Box # :
 City, State, ZIP Code :
 Board of Agriculture, Division of Water Resources
 Application Number:

3 LOCATE WELL'S LOCATION WITH AN "X" IN SECTION BOX:

 4 DEPTH OF COMPLETED WELL: **22'** ft. ELEVATION:
 Depth(s) Groundwater Encountered 1. ft. 2. ft. 3. ft.
 WELL'S STATIC WATER LEVEL **10'** ft. below land surface measured on mo/day/yr **9/2/93**
 Pump test data: Well water was ft. after hours pumping gpm
 Est. Yield gpm: Well water was ft. after hours pumping gpm
 Bore Hole Diameter in. to ft., and in. to ft.
 WELL WATER TO BE USED AS: 5 Public water supply 8 Air conditioning 11 Injection well
 1 Domestic 3 Feedlot 6 Oil field water supply 9 Dewatering 12 Other (Specify below)
 2 Irrigation 4 Industrial **7 Lawn and garden only** 10 Monitoring well
 Was a chemical/bacteriological sample submitted to Department? Yes.....No. **X**.....; If yes, mo/day/yr sample was submitted
 Water Well Disinfected? Yes **X** No

5 TYPE OF BLANK CASING USED:
 1 Steel 3 RMP (SR) 5 Wrought iron 8 Concrete tile CASING JOINTS: Glued Clamped
 2 PVC 4 ABS 6 Asbestos-Cement 9 Other (specify below) Welded
 7 Fiberglass **galv. pipe, 2"** Threaded. **X**.....
 Blank casing diameter **2"** in. to ft., Dia in. to ft., Dia in. to ft.
 Casing height above land surface **0** in., weight lbs./ft. Wall thickness or gauge No.
 TYPE OF SCREEN OR PERFORATION MATERIAL:
 1 Steel 3 Stainless steel 5 Fiberglass 7 PVC 10 Asbestos-cement
 2 Brass 4 Galvanized steel 6 Concrete tile 8 RMP (SR) 11 Other (specify) **NA**
 9 ABS 12 None used (open hole)
 SCREEN OR PERFORATION OPENINGS ARE:
 1 Continuous slot 3 Mill slot 5 Gauzed wrapped 8 Saw cut 11 None (open hole)
 2 Louvered shutter 4 Key punched 6 Wire wrapped 9 Drilled holes
 7 Torch cut 10 Other (specify) **NA**
 SCREEN-PERFORATED INTERVALS: From **NA** ft. to **NA** ft., From ft. to ft.
 From ft. to ft., From ft. to ft.
 GRAVEL PACK INTERVALS: From ft. to ft., From ft. to ft.
 From ft. to ft., From ft. to ft.

6 GROUT MATERIAL: 1 Neat cement 2 **Cement grout** 3 Bentonite 4 Other
 Grout intervals: From ft. to **0** ft., From ft. to ft., From ft. to ft.
 What is the nearest source of possible contamination: ****see attachment**
 1 Septic tank 4 Lateral lines 7 Pit privy 10 Livestock pens 14 Abandoned water well
 2 Sewer lines 5 Cess pool 8 Sewage lagoon 11 Fuel storage 15 Oil well/Gas well
 3 Watertight sewer lines 6 Seepage pit 9 Feedyard 12 Fertilizer storage 16 Other (specify below)
 13 Insecticide storage
 Direction from well? How many feet?

FROM	TO	LITHOLOGIC LOG	FROM	TO	PLUGGING INTERVALS
					2 gallons bleach
					approx. 3 wheelbarrows sand
					12" of concrete
			22	10"	SAND
			10'	0	CEMENT

7 CONTRACTOR'S OR LANDOWNER'S CERTIFICATION: This water well was (1) constructed, (2) reconstructed, or (3) **plugged** under my jurisdiction and was completed on (mo/day/year) **9/22/93** and this record is true to the best of my knowledge and belief. Kansas Water Well Contractor's License No. This Water Well Record was completed on (mo/day/yr) **9/25/93** under the business name of **Keith Brewer** by (signature)