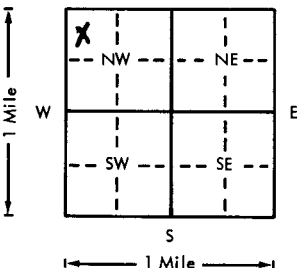


USE TYPEWRITER OR BALL
POINT PEN-PRESS FIRMLY,
PRINT CLEARLY.

WATER WELL RECORD
KSA 82a-1201-1215

Kansas Department of Health and
Environment-Division of Environment
(Water well Contractors)
Topeka, Kansas 66620

1. Location of well: County <u>Sedgwick</u>		Fraction <u>NE SW 1/4 NW 1/4 NW 1/4</u>	Section number <u>32</u>	Township number <u>T 26 S</u>	Range number <u>R 1 E</u>	
2. Distance and direction from nearest town or city: Street address of well location if in city: <u>3630 Payne Wichita, Kansas</u>			3. Owner of well: <u>M. L. Glover</u> R.R. or street: <u>3630 Payne</u> City, state, zip code: <u>Wichita Kansas</u>			
4. Locate with "X" in section below: N W E S 1 Mile		Sketch map: 		6. Bore hole dia. <u>4 1/2</u> in. Completion date <u>8-4-76</u> Well depth <u>45</u> ft.		
5. Type and color of material		From		To		
		<u>Topsail</u>		<u>0</u>	<u>4</u>	
		<u>Brown Clay</u>		<u>4</u>	<u>16</u>	
		<u>Fine Sand</u>		<u>16</u>	<u>22</u>	
		<u>Blue Clay</u>		<u>22</u>	<u>24</u>	
<u>Medium Sand</u>		<u>24</u>	<u>44</u>			
<u>Blue Shale</u>		<u>44</u>	<u>45</u>			
				7. <input checked="" type="checkbox"/> Cable tool <input checked="" type="checkbox"/> Rotary <input type="checkbox"/> Driven <input type="checkbox"/> Dug <input type="checkbox"/> Hollow rod <input type="checkbox"/> Jetted <input type="checkbox"/> Bored <input type="checkbox"/> Reverse rotary		
				8. Use: <input type="checkbox"/> Domestic <input type="checkbox"/> Public supply <input type="checkbox"/> Industry <input type="checkbox"/> Irrigation <input type="checkbox"/> Air conditioning <input type="checkbox"/> Stock <input checked="" type="checkbox"/> Lawn <input type="checkbox"/> Oil field water <input type="checkbox"/> Other		
				9. Casing: Material <u>Aluminum</u> Height: <u>Above</u> or below Threaded <input type="checkbox"/> Welded <input checked="" type="checkbox"/> Surface <u>12</u> in. RMP <input checked="" type="checkbox"/> PVC <input type="checkbox"/> Weight <u>96</u> lbs./ft. Dia. <u>5</u> in. to <u>45</u> ft. depth Wall Thickness: inches or Dia. <u>5</u> in. to <u>45</u> ft. depth gage No. <u>200</u>		
				10. Screen: Manufacturer's name <u>Sunflower</u> <u>Plastic</u> Type <u>Styrene</u> Dia. <u>5"</u> Slot gauge <u>.06</u> Length <u>15</u> ft. Set between <u>30</u> ft. and <u>45</u> ft. Gravel pack <u>yes</u> Size range of material <u>1/4-1/8"</u>		
				11. Static water level: <u>18</u> ft. below land surface Date <u>8-4-76</u> mo./day/yr.		
				12. Pumping level below land surfaces: ____ ft. after ____ hrs. pumping ____ g.p.m. ____ ft. after ____ hrs. pumping ____ g.p.m. Estimated maximum yield ____ g.p.m.		
				13. Water sample submitted: ____ mo./day/yr. Yes ____ No ____ Date ____		
				14. Well head completion: <u>12</u> <u>Capped</u> Pitless adapter ____ Inches above grade		
				15. Well grouted? <u>yes</u> With: <input type="checkbox"/> Neat cement <input type="checkbox"/> Bentonite <input checked="" type="checkbox"/> Concrete Depth: From <u>40</u> ft. to <u>14</u> ft.		
				16. Nearest source of possible contamination: <u>100</u> ft. Direction <u>West</u> Type <u>City Sewer</u> Well disinfected upon completion? <input checked="" type="checkbox"/> Yes ____ No ____		
				17. Pump: <input checked="" type="checkbox"/> Not installed Manufacturer's name ____ Model number ____ HP ____ Volts ____ Length of drop pipe ____ ft. capacity ____ g.p.m. Type: ____ Submersible ____ Turbine ____ Jet ____ Reciprocating ____ Centrifugal ____ Other		
18. Elevation:		19. Remarks: <u>Flat Ground</u>		20. Water well contractor's certification: This well was drilled under my jurisdiction and this report is true to the best of my knowledge and belief. <u>Harpur Wells Pump</u> <u>236</u> Business name <u>Wichita</u> <u>Kansas</u> License No. ____ Address ____ Signed <u>M. Arnold</u> Date <u>8-12-76</u> Authorized representative		

Forward the white, blue and pink copies to the Department of Health and Environment

Form WWC-5