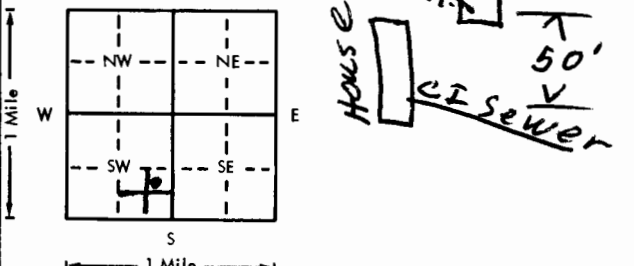


USE TYPEWRITER OR BALL  
POINT PEN-PRESS FIRMLY,  
PRINT CLEARLY.

**WATER WELL RECORD**  
**KSA 82g-1201-1215**

Kansas Department of Health and  
Environment-Division of Environment  
(Water well Contractors)  
Topeka, Kansas 66620

County: <u>Sedgwick</u>		Fraction: <u>NE 1/4 SE 1/4 SW 1/4</u>	Section number: <u>32</u>	Township number: <u>T 26 S</u>	Range number: <u>R 1E</u>
1. Location of well:			2. Distance and direction from nearest town or city:		
Street address of well location if in city: <u>3112 MASCOT</u>			3. Owner of well: <u>WE HIXON</u> R.R. or street: <u>3112 MASCOT</u> City, state, zip code: <u>WICHITA KS 67204</u>		
4. Locate with "X" in section below: 			6. Bore hole dia. <u>9</u> in. Completion date <u>5-20-77</u> Well depth <u>30</u> ft.		
5. Type and color of material			7. <input type="checkbox"/> Cable tool <input type="checkbox"/> Rotary <input type="checkbox"/> Driven <input type="checkbox"/> Dug <input type="checkbox"/> Hollow rod <input type="checkbox"/> Jetted <input checked="" type="checkbox"/> Bored <input type="checkbox"/> Reverse rotary		
8. Use: <input type="checkbox"/> Domestic <input type="checkbox"/> Public supply <input type="checkbox"/> Industry <input checked="" type="checkbox"/> Irrigation <input type="checkbox"/> Air conditioning <input type="checkbox"/> Stock <input checked="" type="checkbox"/> Lawn <input type="checkbox"/> Oil field water <input type="checkbox"/> Other			9. Casing: Material <u>PVC</u> Height: <u>0</u> above or below Threaded <input type="checkbox"/> Welded <u>6ld</u> Surface <u>12</u> in. RMP <input type="checkbox"/> PVC <input type="checkbox"/> Weight <u>      </u> lbs./ft. Dia. <u>4</u> in. to <u>0</u> ft. depth Wall Thickness: inches or Dia. <u>6</u> in. to <u>30</u> ft. depth Gage No. <u>1330</u>		
10. Screen: Manufacturer's name <u>Surplower</u> Type <u>PVC</u> Dia. <u>4"</u> Slot/Gauze <u>3/16</u> Length <u>5 ft</u> Set between <u>25</u> ft. and <u>30</u> ft. ft. and <u>      </u> ft. Gravel pack? <u>NO</u> Size range of material <u>      </u>			11. Static water level: <u>      </u> mo./day/yr. <u>20</u> ft. below land surface Date <u>5-20-77</u>		
12. Pumping level below land surfaces: <u>21</u> ft. after <u>12</u> hrs. pumping <u>15</u> g.p.m. <u>      </u> ft. after <u>      </u> hrs. pumping <u>      </u> g.p.m. Estimated maximum yield <u>50</u> g.p.m.			13. Water sample submitted: <u>      </u> mo./day/yr. <u>      </u> Yes <input checked="" type="checkbox"/> No <input type="checkbox"/> Date <u>      </u>		
14. Well head completion: <u>      </u> <u>      </u> Pitless adapter <u>12</u> Inches above grade			15. Well grouted? <u>yes</u> With: <u>      </u> Neat Cement <u>      </u> Bentonite <input checked="" type="checkbox"/> Concrete Depth: From <u>0</u> ft. to <u>14</u> ft.		
16. Nearest source of possible contamination: <u>CI</u> <u>50'</u> ft. Direction <u>SOUTH</u> Type <u>SEWER</u> Well disinfected upon completion? <input checked="" type="checkbox"/> Yes <input type="checkbox"/> No			17. Pump: <input checked="" type="checkbox"/> Not installed Manufacturer's name <u>      </u> Model number <u>      </u> HP <u>      </u> Volts <u>      </u> Length of drop pipe <u>      </u> ft. capacity <u>      </u> g.p.m. Type: <input type="checkbox"/> Submersible <input type="checkbox"/> Turbine <input type="checkbox"/> Jet <input type="checkbox"/> Reciprocating <input type="checkbox"/> Centrifugal <input type="checkbox"/> Other		
18. Elevation:			19. Remarks: <u>LAWN &amp; Garden</u>		
20. Water well contractor's certification: This well was drilled under my jurisdiction and this report is true to the best of my knowledge and belief. <u>Protheroe Pump</u> <u>295</u> Business name License No. Address <u>827 W 27th St</u> Signed <u>[Signature]</u> Date <u>5-20-77</u> Authorized representative					

Forward the white, blue and pink copies to the Department of Health and Environment

Form WWC-5

MI-1023