USE TYPEWRITER OR BALL POINT PEN-PRESS FIRMLY, PRINT CLEARLY.

T	R	EW	sec 1/4	1/4	1/4	No.

WATER WELL RECORD
KSA 82a-1201-1215

Kansas State Dept. Of Health
(Water Well Contractors)
Forbes-Bldg. 740
Topeka, Kansas 66620

1 Location of well:	County	Township name	Fraction	Section number	Town number	Range number
	Sedgwick	Rechi	SW1/4 of SW1/4	32	26	1E

Distance and direction from nearest town or city: in Wichita

Street address of well location if in city: 1044 W 29th N.

3 Owner of well: Shafer Abraham
Address: 1044 W 29th N. Wichita Kans

Locate with "X" in section below:

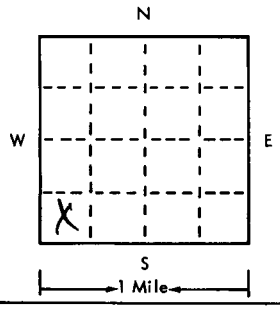

Sketch map:

4 Well depth: 34 ft. Date of completion 3-26-75
Well diameter 5 in.

5 ☐ Cable tool ☐ Rotary ☒ Driven ☐ Dug
☐ Hollow rod ☐ Jetted ☒ Bored ☐ Reverse rotary

6 Use: ☐ Domestic ☐ Public supply ☐ Industry
☐ Irrigation ☒ Air conditioning ☐ Commercial
☐ Test well ☐

7 Casing: Material Steel Height: above/below
Threaded ☒ Welded ☐ Surface 18 in.
Diam. Weight 2.28 lbs./ft.
5 in. to 16 ft. depth Drive shoe? ☐ Yes ☒ No
1.25 in. to 35 ft. depth

2 Type and color of material	From	To
Soil & Sand bore hole	0'	15'
Drove 1.25 pipe	15'	31'
Sand point	31'	35'
(use a second sheet if needed)		

8 Screen:
Manufacturer Johnson
Type Steel Dia. 1.25"
Slot/gauze #10 Length 45"
Set between 31 ft. and 35 ft.
Fittings:
Gravel pack ☐ Yes ☒ No Size range of material

9 Static water level:
15 ft. below land surface Date 3-26-75

10 Pumping level below land surfaces:
15 ft. after 1 hrs. pumping 10 g.p.m.
ft. after hrs. pumping g.p.m.
Estimated maximum yield 60 g.p.m.

11 Water sample submitted:
☐ Yes ☒ No Date

12 Well head completion:
☐ Pitless adapter 18" ☒ Inches above grade

13 Well grouted? ☒ Yes ☐ No
☐ Neat cement ☒ Bentonite ☐
Depth: From 0 ft. to 15 ft.

14 Nearest source of possible contamination:
ft. 100 Direction West Type River
Well disinfected upon completion? ☐ Yes ☒ No

15 Pump: ☒ Not installed
Manufacturer's name Jacuzzi
Model number HP 1/2 Volts 115
Length of drop pipe 31 ft. capacity 10 g.m.p.
Type:
☐ Submersible ☐ Turbine
☒ Jet ☐ Reciprocating
☐ Certrifugal ☐ Other

16 Remarks: elevation

Topography:
☐ Hill
☐ Slope
☐ Upland
☒ Valley

17 Water well contractor's certification:
This well was drilled under my jurisdiction and this report is true to the best of my knowledge and belief.
Q I S Electric Inc 129
Business name License No.
Address 512 W 21st - Wichita
Signed [signature] Date 3-26-75
Authorized representative

Forward the white, blue and pink copies to the Kansas State Dept. Of Health.

Form WWC-5

677-H