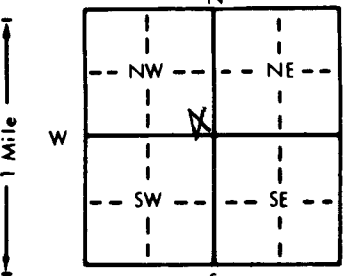


1 LOCATION OF WATER WELL: County: <u>SEDGWICK</u>		Fraction <u>SE</u> $\frac{1}{4}$ <u>SE</u> $\frac{1}{4}$ <u>NW</u> $\frac{1}{4}$	Section Number <u>34</u>	Township Number T <u>26</u> S	Range Number R <u>1</u> <u>EW</u>
Distance and direction from nearest town or city street address of well if located within city? <u>3600 N HYDRAULIC (INSIDE PLANT)</u>					
2 WATER WELL OWNER: <u>COLEMAN CO</u> RR#, St. Address, Box # : <u>3600 N HYDRAULIC</u> City, State, ZIP Code : <u>WICHITA KS</u>		Board of Agriculture, Division of Water Resources Application Number: <u>MW-5</u>			

OPENINGS ARE: 1 Continuous slot <u>3 Mill slot</u> 5 Gauzed wrapped 8 Saw cut 11 None (open hole) 2 Louvered shutter 4 Key punched 6 Wire wrapped 9 Drilled holes 10 Other (specify) SCREEN-PERFORATED INTERVALS: From <u>28</u> ft. to <u>32</u> ft. From <u>28</u> ft. to <u>32</u> ft. From <u>28</u> ft. to <u>32</u> ft. From <u>28</u> ft. to <u>32</u> ft. GRAVEL PACK INTERVALS: From <u>26</u> ft. to <u>32</u> ft. 
6 GROUT MATERIAL: 1 Neat cement 2 Cement grout <u>3 Bentonite</u> 4 Other Grout Intervals: From <u>0</u> ft. to <u>26</u> ft. What is the nearest source of possible contamination: 1 Septic tank 4 Lateral lines 7 Pit privy 10 Livestock pens 14 Abandoned water well 2 Sewer lines 5 Cess pool 8 Sewage lagoon 11 Fuel storage 15 Oil well/Gas well 3 Watertight sewer lines 6 Seepage pit 9 Feedyard 12 Fertilizer storage 16 Other (specify below) <u>PLANT</u> 13 Insecticide storage Direction from well? <u>PLANT</u>		How many feet? FROM TO LITHOLOGIC LOG FROM TO PLUGGING INTERVALS 0 8 Silty Clay 8 28 Sandy Clay 28 31 Fine to med sand 31 32 Shale			
7 CONTRACTOR'S OR LANDOWNER'S CERTIFICATION: This water well was (1) constructed, (2) reconstructed, or (3) plugged under my jurisdiction and was completed on (mo/day/year) <u>2/15/91</u> and this record is true to the best of my knowledge and belief. Kansas Water Well Contractor's License No. <u>102</u> This Water Well Record was completed on (mo/day/yr) <u>3/15/91</u> under the business name of <u>Layne Western Co</u> by (signature) <u>[Signature]</u>					

INSTRUCTIONS: Use typewriter or ball point pen. PLEASE PRESS FIRMLY and PRINT clearly. Please fill in blanks, underline or circle the correct answers. Send top three copies to Kansas Department of Health and Environment, Bureau of Water, Topeka, Kansas 66620-7320. Telephone: 913-296-5545. Send one to WATER WELL OWNER and retain one for your records.

22-900126007