


1 LOCATION OF WATER WELL:	Fraction	Section Number	Township Number	Range Number
County: <u>Sedawick</u>	<u>NE</u> $\frac{1}{4}$ <u>NE</u> $\frac{1}{4}$ <u>NW</u> $\frac{1}{4}$	<u>34</u>	T <u>26</u> S	R <u>1</u> <u>EW</u>

2100 E. 37th N.

MW 8

Board of Agriculture, Division of Water Resources
Application Number:

4 DEPTH OF COMPLETED WELL... 20 ft. ELEVATION

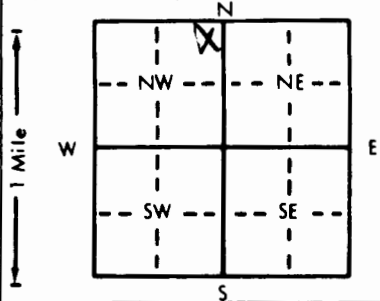

Depth(s) Groundwater Encountered 1. ft. 2. ft. 3. ft.
WELL'S STATIC WATER LEVEL 3 ft. below land surface measured on mo/day/yr
Pump test data: Well water was ft. after hours pumping gpm
Est. Yield gpm Well water was ft. after hours pumping gpm
Bore Hole Diameter. 8 in. to 20 ft., and in. to ft.
WELL WATER TO BE USED AS: 5 Public water supply 8 Air conditioning 11 Injection well
1 Domestic 3 Feedlot 6 Oil field water supply 9 Dewatering 12 Other (Specify below)
2 Irrigation 4 Industrial 7 Lawn and garden only 10 Monitoring well
Was a chemical/bacteriological sample submitted to Department? Yes No If yes, mo/day/yr sample was sub-
mitted Water Well Disinfected? Yes No

5 Wrought iron	8 Concrete tile	CASING JOINTS: Glued	Clamped
6 Asbestos-Cement	9 Other (specify below)	Welded	
7 Fiberglass	<u>SS</u>	Threaded	<u>/</u>

Blank casing diameter 2 in. to 7.5 ft., Dia. in. to ft., Dia. in. to ft.
Casing height above land surface in., weight lbs./ft. Wall thickness or gauge No.

TYPE OF SCREEN OR PERFORATION MATERIAL:

1 Steel	3 Stainless steel	5 Fiberglass	8 RMP (SR)	11 Other (specify)
2 Brass	4 Galvanized steel	6 Concrete tile	9 ABS	12 None used (open hole)

SCREEN OR PERFORATION OPENINGS ARE:

1 Continuous slot 3 Mill slot 6 Wire wrapped 9 Drilled holes
2 Louvered shutter 4 Key punched 7 Torch cut 10 Other (specify)

SCREEN-PERFORATED INTERVALS: From 7.5 ft. to 17.5 ft. From _____ ft. to _____ ft.

From ft. to ft., From ft. to ft.

GRAVEL PACK INTERVALS: From 6.5 ft. to 20 ft. From _____ ft. to _____ ft.
From _____ ft. to _____ ft. From _____ ft. to _____ ft.

6 GROUT MATERIAL: 1 Neat cement 2 Cement grout 3 Bentonite 4 Other

Grout Intervals: From 0 ft. to 6.5 ft. From ft. to ft. From ft. to ft.

What is the nearest source of possible contamination:

1 Septic tank	4 Lateral lines	7 Pit privy	10 Livestock pens	14 Abandoned water well
2 Sewer lines	5 Cess pool	8 Sewage lagoon	11 Fuel storage	15 Oil well/Gas well
3 Watertight sewer lines	6 Seepage pit	9 Feedyard	12 Fertilizer storage	16 Other (specify below)
			13 Insecticide storage	<i>Industrial</i>

Direction from well? *Within* How many feet? *Within*

FROM	TO	LITHOLOGIC LOG	FROM	TO	PLUGGING INTERVALS
------	----	----------------	------	----	--------------------

0	15	Silty clay			
---	----	------------	--	--	--

[illegible][illegible]

13	10	Clay w/ sandy sand			
----	----	--------------------	--	--	--

[illegible][illegible]

1	2	
---	---	---	---	---	---	---	---	---	----	----	-----	-----	

[illegible][illegible][illegible][illegible][illegible]

--	--	--	--	--	--	--

--	--	--	--	--	--

[illegible]

7. CONTRACTOR'S OR LANDOWNER'S CERTIFICATION: This water well was (1) constructed, (2) reconstructed, or (3) plugged under my jurisdiction and was

7. CONTRACTOR'S OR LANDOWNER'S CERTIFICATION: This water well was (1) constructed, (2) reconstructed, or (3) plugged under my jurisdiction and was
 12/14/92
 and this record is true to the best of my knowledge and belief. Kansas


Water Well Contractor's License No. P102 This Water Well Record was completed on (mo/day/yr) 12/21/12

under the business name of Rayne by (signature) [Signature]


of Health and Environment, Bureau of Water, Topeka, Kansas 66620-0001. Telephone: 913-296-3343. Send one to WATER WELL OWNER and retain one for your records.
