

1	LOCATION OF WATER WELL: County: <u>Sedgewick</u>	Fraction <u>NE</u> $\frac{1}{4}$ <u>NE</u> $\frac{1}{4}$ <u>NW</u> $\frac{1}{4}$	Section Number <u>34</u>	Township Number T <u>26</u> S	Range Number R <u>1</u> <u>E</u> <u>W</u>
---	---	---	-----------------------------	----------------------------------	--

Distance and direction from nearest town or city street address of well if located within city? MW 9
2100 E. 37th N.


2	WATER WELL OWNER:	Unocal	
	RR#, St. Address, Box # :	2100 E. 37 th	Wichita Ks
	City, State, ZIP Code :		

Board of Agriculture, Division of Water Resources

Application Number:

3 LOCATE WELL'S LOCATION WITH AN "X" IN SECTION BOX:

4 DEPTH OF COMPLETED WELL. 35 ft. ELEVATION:

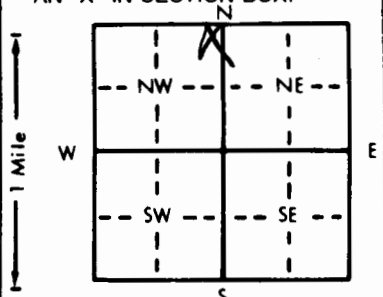

Depth(s) Groundwater Encountered 1. 8 ft. 2. _____ ft. 3. _____ ft.

WELL'S STATIC WATER LEVEL _____ ft. below land surface measured on mo/day/yr _____

Pump test data: Well water was _____ ft. after _____ hours pumping _____ gpm

Est. Yield _____ gpm Well water was _____ ft. after _____ hours pumping _____ gpm

Bore Hole Diameter 8 in. to 35 ft., and _____ in. to _____ ft.

WELL WATER TO BE USED AS:

1 Domestic	3 Feedlot	6 Oil field water supply	9 <u>Dewatering</u>	12 Other (Specify below)
2 Irrigation	4 Industrial	7 Lawn and garden only	10 <u>Monitoring well</u>	

Was a chemical/bacteriological sample submitted to Department? Yes _____ No _____; If yes, mo/day/yr sample was submitted _____

Water Well Disinfected? Yes _____ No _____

5 TYPE OF BLANK CASING USED:		5 Wrought iron	8 Concrete tile	CASING JOINTS: Glued Clamped	
1 Steel	3 RMP (SR)	6 Asbestos-Cement	9 Other (specify below)	Welded	
2 PVC	4 ABS	7 Fiberglass		Threaded	
Blank casing diameter in. to ft., Dia		 in. to ft., Dia		 in. to ft.	
Casing height above land surface in., weight lbs./ft.		Wall thickness or gauge No.			

TYPE OF SCREEN OR PERFORATION MATERIAL:

1 Steel	2 Stainless steel	5 Fiberglass	7 PVC	10 Asbestos-cement
2 Brass	4 Galvanized steel	6 Concrete tile	8 RMP (SR)	11 Other (specify)
			9 ABS	12 None used (open hole)

SCREEN OR PERFORATION OPENINGS ARE:		5 Gauzed wrapped	8 Saw cut	11 None (open hole)
1 Continuous slot	3 Mill slot	6 Wire wrapped	9 Drilled holes	
2 Louvered shutter	4 Key punched	7 Torch cut	10 Other (specify)	
SCREEN-PERFORATED INTERVALS:	From 13	ft. to 33	ft. From	ft. to
	From 12	ft. to 33	ft. From	ft. to
GRAVEL PACK INTERVALS:	From	ft. to	ft. From	ft. to
	From	ft. to	ft. From	ft. to

6 GROUT MATERIAL: 1 Neat cement 2 Cement grout 3 Bentonite 4 Other

Grout Intervals: From 0 ft. to 12 ft., From ft. to ft., From ft. to ft.

What is the nearest source of possible contamination:

1 Septic tank	4 Lateral lines	7 Pit privy	10 Livestock pens	14 Abandoned water well
2 Sewer lines	5 Cess pool	8 Sewage lagoon	11 Fuel storage	15 Oil well/Gas well
3 Watertight sewer lines	6 Seepage pit	9 Feedyard	12 Fertilizer storage	16 Other (specify below)

Direction from well? 11 ft. Industrial

How many feet? 11 ft.

Direction from well?		<i>down</i>		LITHOLOGIC LOG		FROM		TO		Flow in any test?		<i>yes</i>		PLUGGING INTERVALS	
----------------------	--	-------------	--	----------------	--	------	--	----	--	-------------------	--	------------	--	--------------------	--

[illegible]

7 CONTRACTOR'S OR LANDOWNER'S CERTIFICATION: This water well was (1) constructed, (2) reconstructed, or (3) plugged under my jurisdiction and was completed on (mo/day/year) 12/14/92 and this record is true to the best of my knowledge and belief. Kansas Water Well Contractor's License No. 102 This Water Well Record was completed on (mo/day/yr) 12/21/92 under the business name of Rayne by (signature) [Signature]