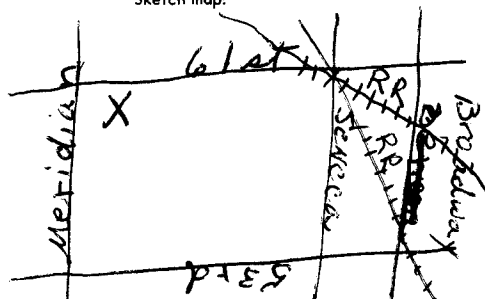


USE TYPEWRITER OR BALL
POINT PEN-PRESS FIRMLY,
PRINT CLEARLY.

WATER WELL RECORD
KSA 820-1201-1215

Kansas Department of Health and
Environment-Division of Environment
(Water well Contractors)
Topeka, Kansas 66620

X Location of well:		County Sedgwick	Fraction NW 1/4 NW 1/4 NW 1/4	Section number 18	Township number T 26	Range number S 1 R 1	EAST MO															
X Distance and direction from nearest town or city: Valley Center 2 m. North			3. Owner of well: Jim Suttle																			
Street address of well location if in city: 2315 Ventoso			R.R. or street: 2315 Ventoso																			
			City, state, zip code: Wichita, Kans																			
4. Locate with "X" in section below:		Sketch map:			6. Bore hole dia. 8 in. Completion date 9/12/77 Well depth 27 ft.																	
<div style="text-align: center;">N 1 Mile W E SW SE S 1 Mile</div>					7. <input checked="" type="checkbox"/> Cable tool <input checked="" type="checkbox"/> Rotary <input type="checkbox"/> Driven <input type="checkbox"/> Dug <input type="checkbox"/> Hollow rod <input type="checkbox"/> Jetted <input type="checkbox"/> Bored <input type="checkbox"/> Reverse rotary																	
5. Type and color of material		<table border="1" style="width:100%; border-collapse: collapse;"><thead><tr><th></th><th>From</th><th>To</th></tr></thead><tbody><tr><td>BLACK DIRT</td><td>0</td><td>3</td></tr><tr><td>YELLOW SAND</td><td>3</td><td>14</td></tr><tr><td>WHITE SAND</td><td>14</td><td>26</td></tr><tr><td>CLAY</td><td>26</td><td>27</td></tr></tbody></table>				From	To	BLACK DIRT	0	3	YELLOW SAND	3	14	WHITE SAND	14	26	CLAY	26	27	8. Use: <input checked="" type="checkbox"/> Domestic <input type="checkbox"/> Public supply <input type="checkbox"/> Industry <input type="checkbox"/> Irrigation <input type="checkbox"/> Air conditioning <input type="checkbox"/> Stock <input type="checkbox"/> Lawn <input type="checkbox"/> Oil field water <input type="checkbox"/> Other		
						From	To															
					BLACK DIRT	0	3															
					YELLOW SAND	3	14															
					WHITE SAND	14	26															
CLAY	26	27																				
9. Casing: Material STEEL Height: (Above or below) Threaded <input type="checkbox"/> Welded <input type="checkbox"/> Surface 12 in. RMP <input type="checkbox"/> PVC <input type="checkbox"/> Weight 100 lbs./ft. Dia. 4 in. to 27 ft. depth Wall Thickness: inches or Dia. <input type="checkbox"/> in. to <input type="checkbox"/> ft. depth gage No. 100																						
10. Screen: Manufacturer's name SUNFLOWER Type 100 Dia. 4" Slot/gauze SHOT Length 5 FT. Set between 22 ft. and 27 ft. <input type="checkbox"/> ft. and <input type="checkbox"/> ft. Gravel pack? NO Size range of material <input type="checkbox"/>																						
11. Static water level: <input type="checkbox"/> mo./day/yr. 11 ft. below land surface Date 9-12-77																						
12. Pumping level below land surfaces: <input type="checkbox"/> ft. after <input type="checkbox"/> hrs. pumping <input type="checkbox"/> g.p.m. <input type="checkbox"/> ft. after <input type="checkbox"/> hrs. pumping <input type="checkbox"/> g.p.m. Estimated maximum yield 10 g.p.m.																						
13. Water sample submitted: <input type="checkbox"/> mo./day/yr. <input type="checkbox"/> Yes <input checked="" type="checkbox"/> No Date <input type="checkbox"/>																						
14. Well head completion: <input type="checkbox"/> Pitless adapter 12 Inches above grade																						
15. Well grouted? YES With: <input checked="" type="checkbox"/> Neat cement <input type="checkbox"/> Bentonite <input type="checkbox"/> Concrete Depth: From 20 ft. to 10 ft.																						
16. Nearest source of possible contamination: ft. 50 Direction SOUTH Type SEWER Well disinfected upon completion? <input checked="" type="checkbox"/> Yes <input type="checkbox"/> No																						
17. Pump: <input checked="" type="checkbox"/> Not installed Manufacturer's name <input type="checkbox"/> Model number <input type="checkbox"/> HP <input type="checkbox"/> Volts <input type="checkbox"/> Length of drop pipe <input type="checkbox"/> ft. capacity <input type="checkbox"/> g.p.m. Type: <input type="checkbox"/> Submersible <input type="checkbox"/> Turbine <input type="checkbox"/> Jet <input type="checkbox"/> Reciprocating <input type="checkbox"/> Centrifugal <input type="checkbox"/> Other																						
18. Elevation:		19. Remarks:		20. Water well contractor's certification: This well was drilled under my jurisdiction and this report is true to the best of my knowledge and belief. Jet Drilling 313 Business name 257 Sabin License No. <input type="checkbox"/> Address Wichita, Kans Signed Walter Landrum 9/12/77 Authorized representative																		

Forward the white, blue and pink copies to the Department of Health and Environment

Form WWC-5

MI-1023