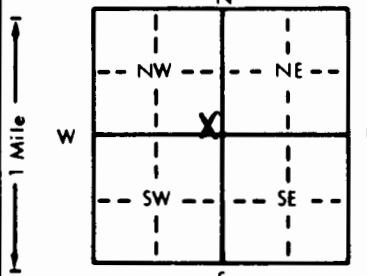


1 LOCATION OF WATER WELL:		Fraction	Section Number	Township Number	Range Number
Distance and direction from nearest town or city street address of well if located within city?					
2 WATER WELL OWNER: <u>JESSIE GONZALES</u>					
RR#, St. Address, Box # : <u>5704 N. ST. CLARA</u>					
City, State, ZIP Code : <u>Wichita, KS</u>					
Board of Agriculture, Division of Water Resources Application Number:					
3 LOCATE WELL'S LOCATION WITH AN "X" IN SECTION BOX:		4 DEPTH OF COMPLETED WELL: <u>35</u> ft. ELEVATION: <u>1150</u>			
		Depth(s) Groundwater Encountered <u>12</u> ft. 2. <u>12</u> ft. 3. <u>12</u> ft.			
		WELL'S STATIC WATER LEVEL <u>12</u> ft. below land surface measured on mo/day/yr <u>8-22-94</u>			
		Pump test data: Well water was <u>12</u> ft. after <u>2</u> hours pumping <u>15</u> gpm			
		Est. Yield <u>20</u> gpm: Well water was <u>12</u> ft. after <u>2</u> hours pumping <u>15</u> gpm			
		Bore Hole Diameter <u>10</u> in. to <u>35</u> ft., and <u>15</u> in. to <u>35</u> ft.			
		WELL WATER TO BE USED AS:			
		5 Public water supply 8 Air conditioning 11 Injection well			
		<input checked="" type="checkbox"/> Domestic 3 Feedlot 6 Oil field water supply 9 Dewatering 12 Other (Specify below)			
		<input checked="" type="checkbox"/> Irrigation 4 Industrial 7 Lawn and garden only 10 Monitoring well			
		Was a chemical/bacteriological sample submitted to Department? Yes <u>X</u> No <u>  </u> If yes, mo/day/yr sample was submitted <u>8-22-94</u>			
		Water Well Disinfected? Yes <u>X</u> No <u>  </u>			
5 TYPE OF BLANK CASING USED:					
1 Steel 3 RMP (SR) 5 Wrought iron 8 Concrete tile CASING JOINTS: Glued <u>  </u> Clamped <u>  </u>					
<input checked="" type="radio"/> PVC 4 ABS 6 Asbestos-Cement 9 Other (specify below) Welded <u>  </u>					
Blank casing diameter <u>5</u> in. to <u>25</u> ft., Dia <u>160</u> in. to <u>160</u> ft., Dia <u>  </u> in. to <u>  </u> ft.					
Casing height above land surface <u>12</u> in., weight <u>160</u> lbs./ft. Wall thickness or gauge No. <u>SDR 26</u>					
TYPE OF SCREEN OR PERFORATION MATERIAL:					
1 Steel 3 Stainless steel 5 Fiberglass 8 RMP (SR) 10 Asbestos-cement					
2 Brass 4 Galvanized steel 6 Concrete tile 9 ABS 11 Other (specify) <u>  </u>					
SCREEN OR PERFORATION OPENINGS ARE:					
1 Continuous slot 3 Mill slot 5 Gauzed wrapped <input checked="" type="radio"/> 8 Saw cut 11 None (open hole)					
2 Louvered shutter 4 Key punched 6 Wire wrapped 9 Drilled holes					
7 Torch cut 10 Other (specify) <u>  </u>					
SCREEN-PERFORATED INTERVALS:					
From <u>25</u> ft. to <u>35</u> ft., From <u>  </u> ft. to <u>  </u> ft.					
From <u>35</u> ft. to <u>15</u> ft., From <u>  </u> ft. to <u>  </u> ft.					
GRAVEL PACK INTERVALS:					
From <u>35</u> ft. to <u>15</u> ft., From <u>  </u> ft. to <u>  </u> ft.					
From <u>  </u> ft. to <u>  </u> ft., From <u>  </u> ft. to <u>  </u> ft.					
6 GROUT MATERIAL:					
1 Neat cement 3 Cement grout 3 Bentonite 4 Other <u>  </u>					
Grout Intervals: From <u>3</u> ft. to <u>15</u> ft., From <u>  </u> ft. to <u>  </u> ft., From <u>  </u> ft. to <u>  </u> ft.					
What is the nearest source of possible contamination:					
1 Septic tank 4 Lateral lines 7 Pit privy 10 Livestock pens 14 Abandoned water well					
2 Sewer lines 5 Cess pool 8 Sewage lagoon 11 Fuel storage 15 Oil well/Gas well					
3 Watertight sewer lines 6 Seepage pit 9 Feedyard 12 Fertilizer storage 16 Other (specify below)					
13 Insecticide storage					
Direction from well? <u>  </u> How many feet? <u>  </u>					
FROM		TO		LITHOLOGIC LOG	
FROM		TO		PLUGGING INTERVALS	
0		2		Top soil	
2		10		Clay	
10		25		Med Sand	
25		35		Coarse Gravel	
7 CONTRACTOR'S OR LANDOWNER'S CERTIFICATION: This water well was <u>(1)</u> constructed, <u>(2)</u> reconstructed, or <u>(3)</u> plugged under my jurisdiction and was completed on (mo/day/year) <u>8-22-94</u> and this record is true to the best of my knowledge and belief. Kansas Water Well Contractor's License No. <u>463</u> This Water Well Record was completed on (mo/day/yr) <u>8-22-94</u> under the business name of <u>SEA</u> by (signature) <u>Dan Perkins</u>					
INSTRUCTIONS: Use typewriter or ball point pen. PLEASE PRESS FIRMLY and PRINT clearly. Please fill in blanks, underline or circle the correct answers. Send top three copies to Kansas Department of Health and Environment, Bureau of Water, Topeka, Kansas 66620-0001. Telephone: 913-296-5545. Send one to WATER WELL OWNER and retain one for your records.					