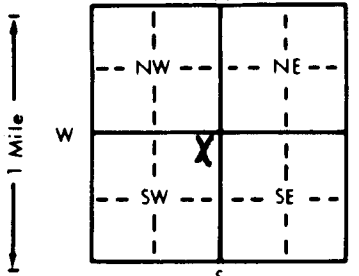


1 LOCATION OF WATER WELL: County: <u>Sedgwick</u> Fraction: <u>NE 1/4 NE 1/4 SW 1/4</u> Section Number: <u>7</u> Township Number: <u>T 26 S</u> Range Number: <u>R 1 E</u>	
Distance and direction from nearest town or city street address of well if located within city? <u>See Below</u>	
2 WATER WELL OWNER: <u>Jim Browale</u> RR#, St. Address, Box #: <u>01930 Quwanston</u> City, State, ZIP Code: <u>Wichita, KS 67204</u> Board of Agriculture, Division of Water Resources Application Number:	
3 LOCATE WELL'S LOCATION WITH AN "X" IN SECTION BOX: 	4 DEPTH OF COMPLETED WELL: <u>30</u> ft. ELEVATION: Depth(s) Groundwater Encountered 1. <u>12</u> ft. below land surface measured on mo/day/yr <u>7-12-94</u> WELL'S STATIC WATER LEVEL <u>12</u> ft. below land surface measured on mo/day/yr Pump test data: Well water was <u>12</u> ft. after <u>1/2</u> hours pumping <u>50</u> gpm Est. Yield <u>50</u> gpm; Well water was <u>30</u> ft. after <u>1/2</u> hours pumping <u>20</u> gpm Bore Hole Diameter <u>11</u> in. to <u>30</u> ft. and <u>11</u> in. to <u>30</u> ft. WELL WATER TO BE USED AS: <input checked="" type="checkbox"/> Domestic 3 Feedlot 6 Oil field water supply 9 Dewatering 12 Other (Specify below) <input type="checkbox"/> Irrigation 4 Industrial 7 Lawn and garden only 10 Monitoring well Was a chemical/bacteriological sample submitted to Department? Yes <u>X</u> No <u>X</u> ; If yes, mo/day/yr sample was submitted Water Well Disinfected? Yes <u>X</u> No <u>X</u>
5 TYPE OF BLANK CASING USED: 1 Steel 3 RMP (SR) 5 Wrought iron 8 Concrete tile CASING JOINTS: Glued <u>X</u> Clamped <u>X</u> <input checked="" type="checkbox"/> 2 PVC 4 ABS 6 Asbestos-Cement 9 Other (specify below) Welded <u>X</u> Blank casing diameter <u>5</u> in. to <u>20</u> ft. Dia. <u>2.60</u> in. to <u>100</u> ft. Dia. <u>100</u> PSI Casing height above land surface <u>12</u> in. weight <u>2.60</u> lbs./ft. Wall thickness or gauge No. <u>100</u> PSI TYPE OF SCREEN OR PERFORATION MATERIAL: 1 Steel 3 Stainless steel 5 Fiberglass 8 RMP (SR) 10 Asbestos-cement 2 Brass 4 Galvanized steel 6 Concrete tile 9 ABS 11 Other (specify) <u>7 PVC</u> SCREEN OR PERFORATION OPENINGS ARE: 1 Continuous slot <input checked="" type="checkbox"/> 3 Mill slot 5 Gauzed wrapped 8 Saw cut 11 None (open hole) 2 Louvered shutter 4 Key punched 6 Wire wrapped 9 Drilled holes 7 Torch cut 10 Other (specify) SCREEN-PERFORATED INTERVALS: From <u>20</u> ft. to <u>30</u> ft. From <u>13</u> ft. to <u>30</u> ft. GRAVEL PACK INTERVALS: From <u>13</u> ft. to <u>30</u> ft. From <u>13</u> ft. to <u>30</u> ft.	
6 GROUT MATERIAL: 1 Neat cement 2 Cement grout 3 Bentonite 4 Other Grout Intervals: From <u>3</u> ft. to <u>13</u> ft. From <u>13</u> ft. to <u>100</u> ft. What is the nearest source of possible contamination: <input checked="" type="checkbox"/> Septic tank 4 Lateral lines 7 Pit privy 10 Livestock pens 14 Abandoned water well 2 Sewer lines 5 Cess pool 8 Sewage lagoon 11 Fuel storage 15 Oil well/Gas well 3 Watertight sewer lines 6 Seepage pit 9 Feedyard 12 Fertilizer storage 16 Other (specify below) Direction from well? <u>North</u> How many feet? <u>100</u>	
FROM TO LITHOLOGIC LOG	FROM TO PLUGGING INTERVALS
0 2 Top Soil	
2 4 Clay	
4 30 gravel	
7 CONTRACTOR'S OR LANDOWNER'S CERTIFICATION: This water well was (1) constructed, (2) reconstructed, or (3) plugged under my jurisdiction and was completed on (mo/day/year) <u>7-12-94</u> and this record is true to the best of my knowledge and belief. Kansas Water Well Contractor's License No. <u>318</u> This Water Well Record was completed on (mo/day/yr) <u>7-19-94</u> under the business name of <u>Weninger Drilling</u> by (signature) <u>Barbara Morrissey</u>	
INSTRUCTIONS: Use typewriter or ball point pen. PLEASE PRESS FIRMLY and PRINT clearly. Please fill in blanks, underline or circle the correct answers. Send top three copies to Kansas Department of Health and Environment, Bureau of Water, Topeka, Kansas 66620-0001. Telephone: 913-296-5545. Send one to WATER WELL OWNER and retain one for your records.	