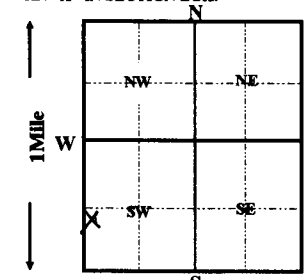


1 LOCATION OF WATER WELL: <b>Sedgwick</b> <i>CS7</i>		FRACTION <b>NW</b> 1/4 <b>SW</b> 1/4 <b>SW</b> 1/4		Section Number <b>19</b>	Township Number <b>T 26 S</b>	Range Number <b>R 1E E/W</b>
Distance and direction from nearest town or city street address of well if located within city? <b>46th N. and Meridian Wichita, Kansas</b>						
2 WATER WELL OWNER: <b>CITY OF WICHITA</b> RR#, ST. ADDRESS, BOX #: <b>P.O. Box 9163</b> CITY, STATE, ZIP CODE: <b>Wichita, Kansas</b>		Board of Agriculture, Division of Water Resource Application Number: <b>95005</b>				
3 LOCATE WELL'S LOCATION WITH AN "X" IN SECTION BOX: 		4 DEPTH OF COMPLETED WELL <b>40</b> ft. ELEVATION: Depth(s) groundwater Encountered <b>1</b> ft. <b>2</b> ft. <b>3</b> ft. <b>ft.</b> WELL'S STATIC WATER LEVEL <b>15</b> FT. BELOW LAND SURFACE MEASURED ON <b>01/13/1995</b> Pump test data: Well water was <b>ft.</b> after <b>hours</b> pumping <b>gpm</b> Est. Yield <b>gpm:</b> Well water was <b>ft.</b> after <b>hours</b> pumping <b>gpm</b> Bore Hole Diameter <b>12</b> in. to <b>40</b> ft. and <b>in.</b> to <b>ft.</b> WELL WATER TO BE USED AS: <b>5</b> Public water supply <b>8</b> Air conditioning <b>11</b> Injection well <b>1</b> Domestic <b>3</b> Feedlot <b>6</b> Oil field water supply <b>9</b> Dewatering <b>12</b> Other (Specify below) <b>2</b> Irrigation <b>4</b> Industrial <b>7</b> Lawn and garden only <b>10</b> Monitoring well Was a chemical/bacteriological sample submitted to Department? Yes <b>No</b> <b>X</b> ; If yes, mo/day/yr sample was submitted Water Well Disinfected? Yes <b>X</b> No				
5 TYPE OF CASING USED: 1 Steel 3 RMP (SR) 5 Wrought iron 8 Concrete tile CASING JOINTS: Glued <b>X</b> Clamped <b>2</b> <u>PVC</u> 4 ABS 6 Asbestos-Cement 9 Other (Specify below) Welded Blank casing Diameter <b>8</b> in. to <b>20</b> ft., Dia in. to ft., Dia in. to ft. Casing height above land surface <b>12</b> in., weight <b>2.35</b> lbs./ft. Wall thickness or gauge No. <b>.214</b> TYPE OF SCREEN OR PERFORATION MATERIAL: <b>7</b> <u>PVC</u> 10 Asbestos-cement 1 Steel 3 Stainless Steel 5 Fiberglass 8 RMP (SR) 11 other (specify) 2 Brass 4 Galvanized steel 6 Concrete tile 9 ABS 12 None used (open hole) SCREEN OR PERFORATION OPENING ARE: <b>5</b> Gauzed wrapped <b>8</b> <u>Saw cut</u> 11 None (open hole) 1 Continuous slot 3 Mill slot 6 Wire wrapped 9 Drilled holes 2 Louvered shutter 4 Key punched 7 Torch cut 10 Other (specify) SCREEN-PERFORATION INTERVALS: from <b>20</b> ft. to <b>40</b> ft., From ft. to ft. GRAVEL PACK INTERVALS: from <b>20</b> ft. to <b>40</b> ft., From ft. to ft. from ft. to ft., From ft. to ft.						
6 GROUT MATERIAL: 1 Neat cement 2 Cement grout 3 Bentonite 4 Other <u>bentonite hole plug</u> Grout Intervals: From <b>4</b> ft. to <b>20</b> ft. From ft. to ft. What is the nearest source of possible contamination: 1 Septic tank 4 Lateral lines 7 Pit privy 10 Livestock pens 14 Abandon water well 2 Sewer lines 5 Cess pool 8 Sewage lagoon 11 Fuel storage 15 Oil well/Gas well 3 Watertight sewer lines 6 Seepage pit 9 Feedyard 12 Fertilizer storage 16 Other (specify below) Direction from well? <b>None Apparent</b> How many feet?						
FROM TO LITHOLOGIC LOG FROM TO PLUGGING INTERVALS 0 3 topsoil 3 11 clay 11 21 fine sand 21 40 medium sand						
7 CONTRACTOR'S OR LANDOWNER'S CERTIFICATION: This water well was (1) <u>constructed</u> , (2) reconstructed, or (3) plugged under my jurisdiction and was completed on (mo/day/year) <b>01/13/1995</b> and this record is true to the best of my knowledge and belief. Kansas Water Well Contractor's License No. <b>236</b> This Water Well Record was completed on (mo/day/yr) <b>01/20/95</b> Under the business name of <b>Harp Well &amp; Pump Service, Inc.</b> by (signature) <i>Jane Frederick</i>						