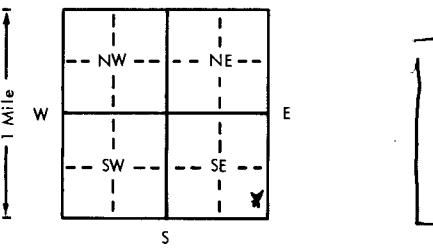


USE TYPEWRITER OR BALL
POINT PEN—PRESS FIRMLY,
PRINT CLEARLY.

WATER WELL RECORD
KSA 820-1201-1215

Kansas Department of Health and
Environment-Division of Environment
(Water well Contractors)
Topeka, Kansas 66620

County Greenwood		Fraction SE 1/4 SE 1/4 SE 1/4	Section number 2	Township number T 26	Range number S R 10 E W
1. Location of well: 1422 E River			3. Owner of well: Paul Bunyard R.R. or street: 1422 E. River City, state, zip code: Eureka, Kansas 67045		
2. Distance and direction from nearest town or city: 1422 E River			4. Locate with "X" in section below: 		
5. Type and color of material			6. Bore hole dia. 10 in. Completion date 4/15/78 Well depth 60 ft.		
7. <input checked="" type="checkbox"/> Cable tool <input type="checkbox"/> Rotary <input type="checkbox"/> Driven <input type="checkbox"/> Dug <input type="checkbox"/> Hollow rod <input type="checkbox"/> Jetted <input type="checkbox"/> Bored <input type="checkbox"/> Reverse rotary			8. Use: <input type="checkbox"/> Domestic <input type="checkbox"/> Public supply <input checked="" type="checkbox"/> Industry <input type="checkbox"/> Irrigation <input type="checkbox"/> Air conditioning <input type="checkbox"/> Stock <input type="checkbox"/> Lawn <input type="checkbox"/> Oil field water <input type="checkbox"/> Other		
9. Casing: Material <input type="checkbox"/> Height: <input checked="" type="checkbox"/> Above or below Threaded <input type="checkbox"/> Welded <input type="checkbox"/> Surface 14 in. RMP <input type="checkbox"/> PVC <input checked="" type="checkbox"/> Weight <input type="checkbox"/> lbs./ft. Dia. 10 in. to 23 ft. depth Wall Thickness: inches or Dia. <input type="checkbox"/> in. to <input type="checkbox"/> ft. depth Gauge No. 1250			10. Screen: Manufacturer's name Uni-Fusion - Okmulgee, KS. Type PVC Dia. 10" Slot/gauze 1/8" Length 3' Set between 20 ft. and 23 ft. Gravel pack? <input checked="" type="checkbox"/> Size range of material 1/2"		
11. Static water level: <input type="checkbox"/> mo./day/yr. 10 ft. below land surface Date 4/15/78			12. Pumping level below land surfaces: ____ ft. after ____ hrs. pumping ____ g.p.m. ____ ft. after ____ hrs. pumping ____ g.p.m. Estimated maximum yield 1.7 g.p.m.		
13. Water sample submitted: ____ mo./day/yr. <input type="checkbox"/> Yes <input checked="" type="checkbox"/> No Date			14. Well head completion: <input type="checkbox"/> Pitless adapter 14" Inches above grade		
15. Well grouted? <input checked="" type="checkbox"/> Yes With: <input type="checkbox"/> Neat cement <input type="checkbox"/> Bentonite <input checked="" type="checkbox"/> Concrete Depth: From 0 ft. to 10 ft.			16. Nearest source of possible contamination: cow lot ft. 50 Direction S Type LOT Well disinfected upon completion? <input type="checkbox"/> Yes <input checked="" type="checkbox"/> No		
17. Pump: <input checked="" type="checkbox"/> Not installed Manufacturer's name Model number ____ HP ____ Volts ____ Length of drop pipe ____ ft. capacity ____ g.p.m. Type: <input type="checkbox"/> Submersible <input type="checkbox"/> Turbine <input type="checkbox"/> Jet <input type="checkbox"/> Reciprocating <input type="checkbox"/> Centrifugal <input type="checkbox"/> Other			18. Elevation: Topography: <input type="checkbox"/> Hill <input type="checkbox"/> Slope <input checked="" type="checkbox"/> Upland <input type="checkbox"/> Valley		
19. Remarks: 14" hole from top to 23' 8" hole from 23' to 60' For Minnow Tanks			20. Water well contractor's certification: This well was drilled under my jurisdiction and this report is true to the best of my knowledge and belief. LADD Drilling Co 358A Business name License No. Address 1422 E River Eureka, KS. Signed John Ladd Date 5/7/78 Authorized representative		

Forward the white, blue and pink copies to the Department of Health and Environment

Farm WWC-5