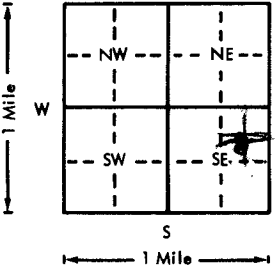
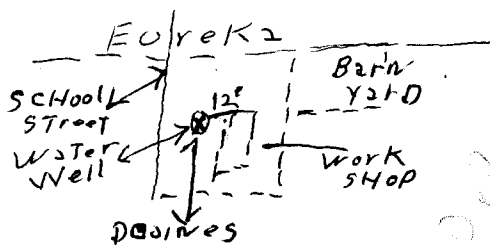


USE TYPEWRITER OR BALL  
POINT PEN-PRESS FIRMLY,  
PRINT CLEARLY.

WATER WELL RECORD  
KSA 82a-1201-1215

Kansas Department of Health and  
Environment-Division of Environment  
(Water well Contractors)  
Topeka, Kansas 66620

1. Location of well: County <u>WAGON WOOD</u> NE 1/4 NE 1/4 SE 1/4		Section number <u>3</u>		Township number <u>T 26 S</u>		Range number <u>R 10 E</u>	
2. Distance and direction from nearest town or city: <u>OUTSIDE OF EUREKA MOORE SOUTH ON SCHOOL STREET</u>				3. Owner of well: <u>DAVE MOCK</u> R.R. or street: <u>410 E. OHIO</u> City, state, zip code: <u>EUREKA, KANS-67045</u>			
4. Locate well in section below:		Sketch map:		6. Bore hole dia. <u>9</u> in. Completion date <u>4-14-76</u> Well depth <u>46</u> ft.			
				7. <input checked="" type="checkbox"/> Cable tool <input type="checkbox"/> Rotary <input type="checkbox"/> Driven <input type="checkbox"/> Dug <input type="checkbox"/> Hollow rod <input type="checkbox"/> Jetted <input type="checkbox"/> Bored <input type="checkbox"/> Reverse rotary			
5. Type and color of material		From		To		8. Use: <input type="checkbox"/> Domestic <input type="checkbox"/> Public supply <input type="checkbox"/> Industry <input checked="" type="checkbox"/> Irrigation <input type="checkbox"/> Air conditioning <input type="checkbox"/> Stock <input checked="" type="checkbox"/> Lawn <input type="checkbox"/> Oil field water <input type="checkbox"/> Other	
Soil		0		4		9. Casing: Material <u>PITS</u> Height: <u>Above</u> or below Threaded <input type="checkbox"/> Welded <input checked="" type="checkbox"/> Surface <u>12</u> in. RMP <input type="checkbox"/> PVC <input checked="" type="checkbox"/> Weight <input type="checkbox"/> lbs./ft. Dia. <u>5</u> in. to <u>46</u> ft. depth Wall Thickness: inches or Dia. <u>5</u> in. to <u>46</u> ft. depth gage No. <u>0.265</u>	
Shale yellow-Red		4		12		10. Screen: Manufacturer's name <u>NA</u> Type <input type="checkbox"/> Dia. <input type="checkbox"/> Slot/gauze <input type="checkbox"/> Length <input type="checkbox"/> Set between <input type="checkbox"/> ft. and <input type="checkbox"/> ft. <input type="checkbox"/> ft. and <input type="checkbox"/> ft. Gravel pack? <u>NO</u> Size range of material <input type="checkbox"/>	
Shale gray		12		16		11. Static water level: <input type="checkbox"/> mo./day/yr. <u>18</u> ft. below land surface Date <u>11-12-76</u>	
Shale Dark		16		18		12. Pumping level below land surfaces: <input type="checkbox"/> ft. after <input type="checkbox"/> hrs. pumping <input type="checkbox"/> g.p.m. <input type="checkbox"/> ft. after <input type="checkbox"/> hrs. pumping <input type="checkbox"/> g.p.m. Estimated maximum yield <u>1</u> g.p.m.	
Clay yellow		18		28		13. Water sample submitted: <input type="checkbox"/> mo./day/yr. <input type="checkbox"/> Yes <input checked="" type="checkbox"/> No Date <input type="checkbox"/>	
lime Dark & Hard		28		31		14. Well head completion: <input type="checkbox"/> Pitless adapter <u>12</u> inches above grade	
Shale gray		31		40		15. Well grouted? <input checked="" type="checkbox"/> Yes With: <input checked="" type="checkbox"/> Neat cement <input type="checkbox"/> Bentonite <input type="checkbox"/> Concrete Depth: From <u>0</u> ft. to <u>14</u> ft.	
lime dark hard		40		46		16. Nearest source of possible contamination: ft. <u>200</u> Direction <u>EAST</u> Type <u>BARN YARD</u> Well disinfected upon completion? <input checked="" type="checkbox"/> Yes <input type="checkbox"/> No	
(Use a second sheet if needed)						17. Pump: <input checked="" type="checkbox"/> Not installed Manufacturer's name <input type="checkbox"/> Model number <input type="checkbox"/> HP <input type="checkbox"/> Volts <input type="checkbox"/> Length of drop pipe <input type="checkbox"/> ft. capacity <input type="checkbox"/> g.p.m. Type: <input type="checkbox"/> Submersible <input type="checkbox"/> Turbine <input type="checkbox"/> Jet <input type="checkbox"/> Reciprocating <input type="checkbox"/> Centrifugal <input type="checkbox"/> Other	
18. Elevation:		19. Remarks:		20. Water well contractor's certification: This well was drilled under my jurisdiction and this report is true to the best of my knowledge and belief. <u>Jeffrey Well Drilling 315</u> Business name <u>Box 346 Eureka Kan</u> License No. <input type="checkbox"/> Address <u>Box 346 Eureka Kan</u> Signed <u>Jack B. Jeffrey</u> Date <u>12-27-76</u> Authorized representative			

Forward the white, blue and pink copies to the Department of Health and Environment

Form WWC-5