

County: Woodson Fraction: NE SW NW Sec. 36 T. 26 S R. 13 E

CORRECTION(S) to WATER WELL COMPLETION RECORD Form WWC-5 (to rectify lacking or incorrect information)

Owner: El Dorado Correctional Facility MW - 1

If location corrected, was listed as:

Section-Township-Range: S26-T26-R13E

Fraction (1/4 calls): SE SW SE

Location changed to:

S36-T26-R13E

NE SW NW

Other changes: Initial statements: Lat./Long coordinates provided were incorrect. Casing height after plugging incorrectly reported as 0 ft.

Changed to: WGS 84 (37.744033, -95.939997)

Casing height after plugging is now 3 ft below land surface.

Comments: _____

Verification method: Confirmed location using site map provided, LeoWeb, and Google Earth.

Initials: BA Date: 4/22/2024

Submitted by: Kansas Geological Survey, Data Resources Library, 1930 Constant Ave., Lawrence, KS 66047-3724
 Kansas Dept. of Health & Environment, Bureau of Water, 1000 SW Jackson, Suite 420, Topeka, KS 66612-1367

WATER WELL PLUGGING RECORD Form WWC-5P

KSA 82a-1212

ID NO.

MW-1

1 LOCATION OF WATER WELL: County: WOODSON	Fraction SW ¼ SE ¼ SW ¼ SE ¼	Section Number 26	Township Number T 26 S	Range Number 13 <input checked="" type="checkbox"/> E <input type="checkbox"/> W
---	---------------------------------	----------------------	---------------------------	---

Street/Rural Address of Well Location; if unknown, distance & direction from nearest town or intersection: If at owner's address, check here

Global Positioning Systems (GPS) information:
 Latitude: 37.75039 (in decimal degrees)
 Longitude: -95.94827 (in decimal degrees)
 Elevation: 975.99
 Horizontal Datum: WGS84, NAD83, NAD27
 Collection Method:

2 WATER WELL OWNER: EL DORADO CORR. FACILIT
 RR#, St. Address, Box #: 172 HWY 105
 City, State ZIP Code: TORONTO, KS 66777

GPS unit (Make/Model: _____)
 Digital Map/Photo, Topographic Map, Land Survey
 Est. Accuracy: < 3 m, 3-5 m, 5-15 m, > 15 m

3 MARK WELL'S LOCATION WITH AN "X" IN SECTION BOX:

N	
NW	NE
SW	SE
S	

X

4 DEPTH OF WELL 42.99 ft.
 WELL'S STATIC WATER LEVEL 12.85 ft.
 WELL WAS USED AS:
 Domestic Public Water Supply Dewatering
 Irrigation Oil Field Water Supply Monitoring
 Feedlot Domestic (Lawn & Garden) Injection Well
 Industrial Air Conditioning Other _____
 Was a chemical/bacteriological sample submitted to Department? Yes No

5 TYPE OF BLANK CASING USED:

Steel RMP (SR) Wrought Fiberglass Other (Specify below) _____
 PVC ABS Asbestos-Cement Concrete Tile _____

Blank casing diameter 2 in. Was casing pulled? Yes No If yes, how much 3'
 Casing height above or below land surface .36 in.

6 GROUT PLUG MATERIAL: Neat cement Cement grout Bentonite Other 0-0.5

Grout Plug Intervals: From 0.5 ft. to 42.99 ft., From _____ ft. to _____ ft., From _____ ft. to _____ ft.


What is the nearest source of possible contamination:
 Septic tank Seepage pit Fuel storage Other (specify below) _____
 Sewer lines Pit privy Fertilizer storage _____
 Watertight sewer lines Sewage lagoon Insecticide storage _____
 Lateral lines Feedyard Abandoned water well Direction from well? _____
 Cess pool Livestock pens Oil well/Gas well How many feet? _____

FROM	TO	PLUGGING MATERIALS	FROM	TO	PLUGGING MATERIALS
0	0.5				
0.5	42.99	BENTONITE			

7 CONTRACTOR'S OR LANDOWNER'S CERTIFICATION: This water well was plugged under my jurisdiction and was completed on (mo/day/year) 3/13/23 and this record is true to the best of my knowledge and belief. Kansas Water Well Contractor's License No. 585. This Water Well Record was completed on (mo/day/year) 3/29/23 under the business name of ASSOCIATED ENVIRONMENTAL INC. by (signature) _____

Send one white copy to Kansas Department of Health & Environment, Geology Section, 1000 SW Jackson Street, Ste. 420, Topeka, KS 66612-1367. Send one copy to WATER WELL OWNER and retain one for your records.
 Visit us at <http://www.kdheks.gov/waterwell/index.html> Telephone 785-296-5524.

KSA82a-1212 Revised 1/20/2015

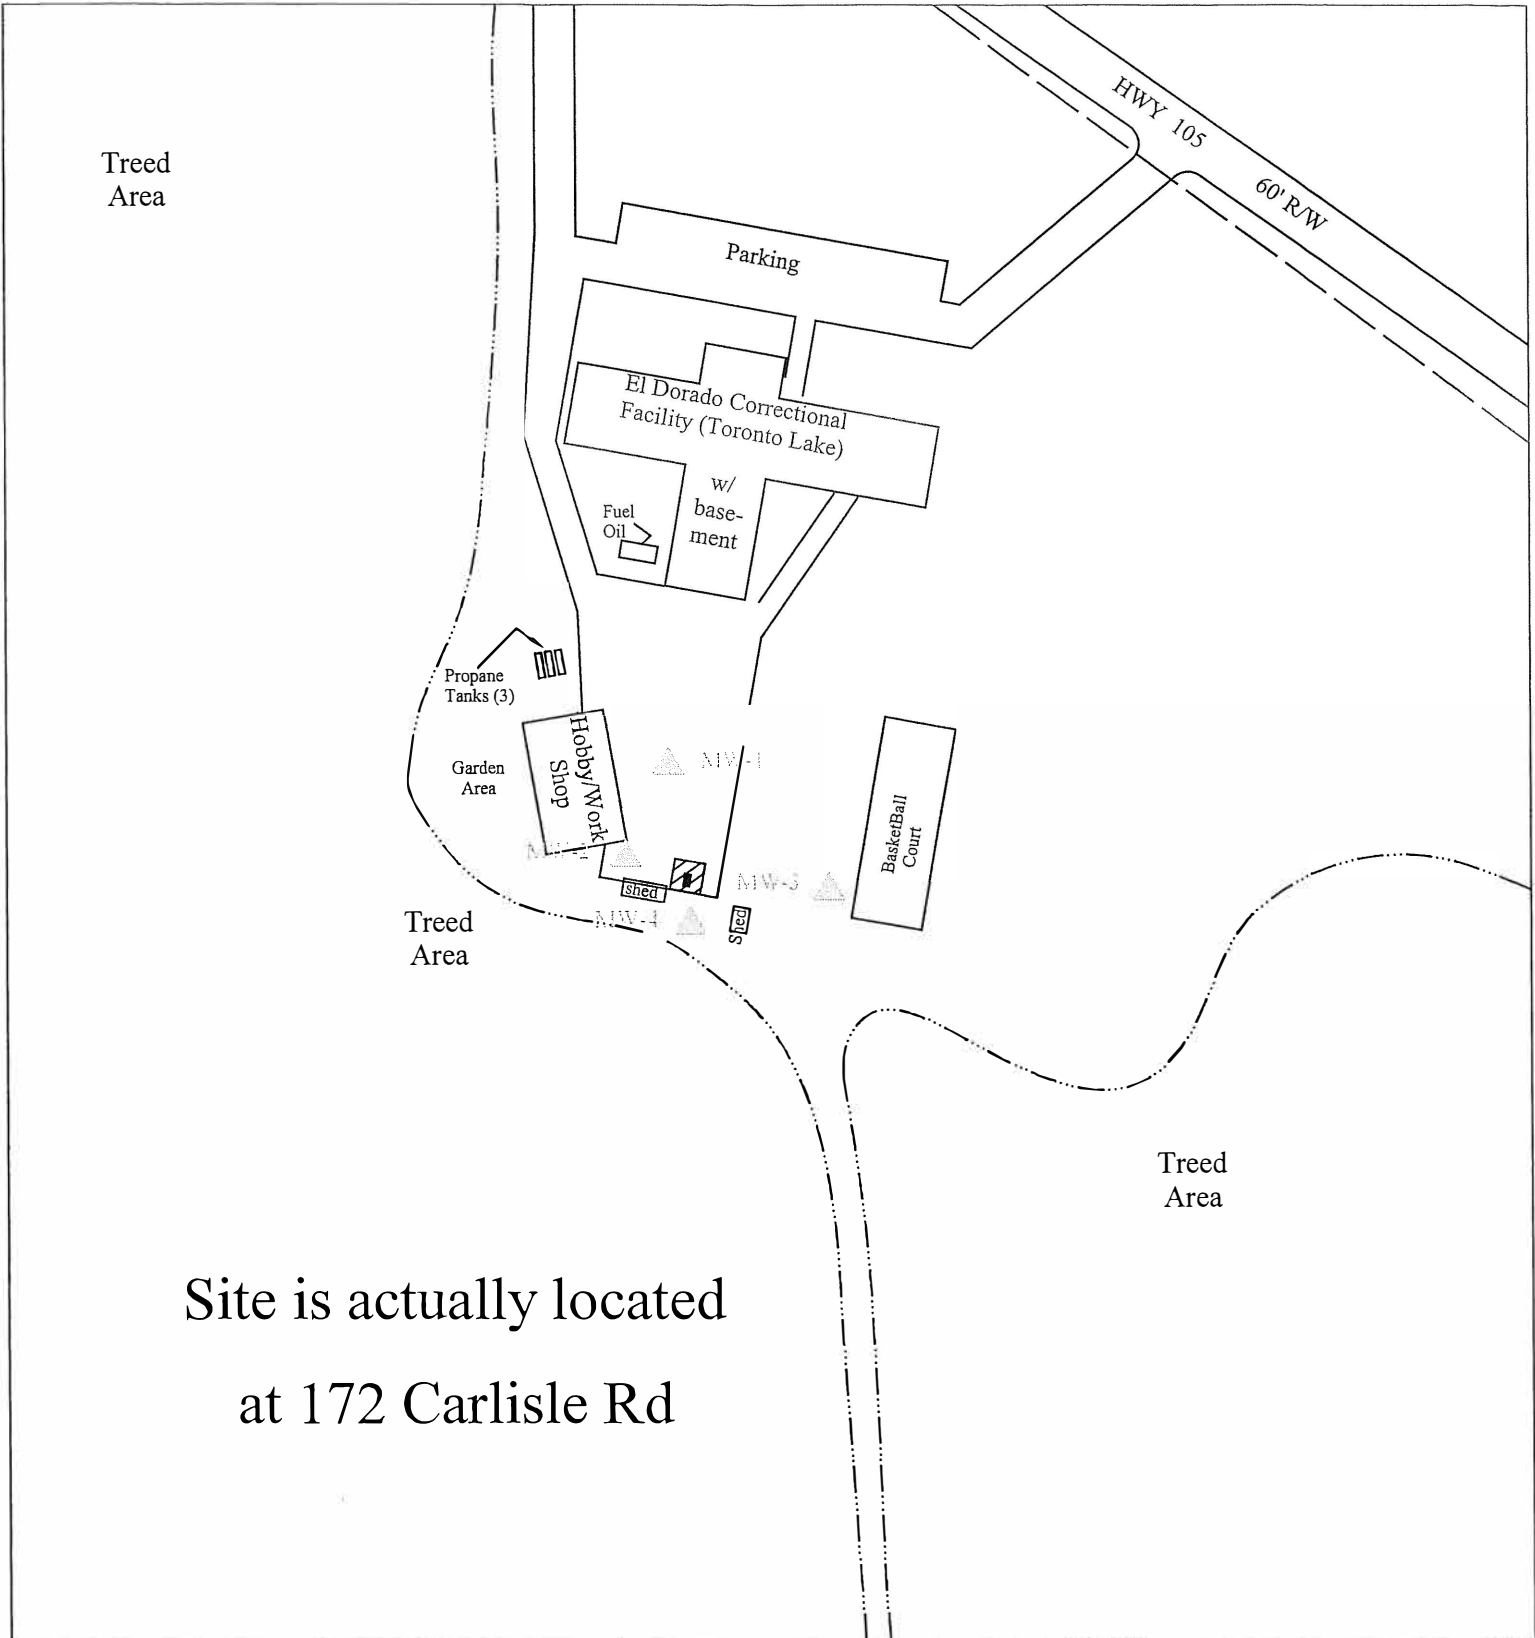

Site is actually located
at 172 Carlisle Rd

PROJECT: El Dorado Correctional Facility

ADDRESS: 172 HWY 105

LOCATION: Toronto, Kansas

DRAWN BY: MD **DATE:** 03/16/04

REVISED BY: B. STALNAKER **DATE:** 3/29/23

AEI JOB #: TF360 **KDHE JOB #:** U3-104-13290

SCALE: 1" = 100'
0 50 100

NOTES: Sample Date: 5/4/21
The former pump island and product line locations are unknown

TITLE:

ASSOCIATED ENVIRONMENTAL INC.

LEGEND:

- = Former UST basin; 2-500 gallon gasoline USTs
- = Current 500 gal gas AST
- = Boundary of treed area
- = Monitor Well location
- = Site Boundary

