

1 LOCATION OF WATER WELL: Fraction **NE 1/4 SW 1/4 NW 1/4** Section Number **36** Township Number **T 26 S** Range Number **R 13 E**
 County: **Woodson**
 Distance and direction from nearest town or city street address of well if located within city?
172 highway 105 Toronto, Kansas

2 WATER WELL OWNER: El Dorado Correctional Facility Howard Burk
 RR#, St. Address, Box # : **172 Highway 105** Board of Agriculture, Division of Water Resources
 City, State, ZIP Code : **Toronto, KS 66777** Application Number:

3 LOCATE WELL'S LOCATION WITH AN "X" IN SECTION BOX:

4 DEPTH OF COMPLETED WELL 46 ft. ELEVATION: NA
 Depth(s) Groundwater Encountered **11.5** ft. 2 **NA** ft. 3 **NA** ft.
 WELL'S STATIC WATER LEVEL **17.47** ft. below land surface measured on **05/20/04**
 Pump test data: Well water was _____ Ft. after _____ hours pumping _____ Gpm
 Est. Yield _____ Gpm: Well water was _____ Ft. after _____ Hours pumping _____ Gpm
 Bore Hole Diameter **6.5** in. to **46** ft. and _____ in. to _____ ft.
 WELL WATER TO BE USED AS: 5 Public water supply 8 Air conditioning 11 Injection well
 1 Domestic 3 Feed lot 6 Oil field water supply 9 Dewatering 12 Other (Specify below)
 2 Irrigation 4 Industrial 7 Lawn and garden (domestic) 10 **Monitoring well MW-2**
 Was a chemical/bacteriological sample submitted to Department? Yes **No X** If yes, mo/day/yr sample was Submitted _____
 Water Well Disinfected? Yes **No X**

5 TYPE OF BLANK CASING USED: 5 Wrought Iron 8 Concrete tile CASING JOINTS: Glued _____ Clamped _____
 1 Steel 3 RMP (SR) 6 Asbestos-Cement 9 Other (specify below) Welded _____
 2 **PVC** 4 ABS 7 Fiberglass **Threaded X**

Blank casing diameter **2** in. to **10.5** Ft. Dia _____ in. to _____ ft. Dia _____ in. to _____ ft.
 Casing height above land surface **FLUSH** in., weight **SCH 40** Lbs./ft. Wall thickness or gauge No. _____

TYPE OF SCREEN OR PERFORATION MATERIAL: 7 **PVC** 10 Asbestos-cement
 1 Steel 3 Stainless steel 5 Fiberglass 8 RMP (SR) 11 Other (specify) _____
 2 Brass 4 Galvanized steel 6 Concrete tile 9 ABS 12 None used (open hole) _____

SCREEN OR PERFORATION OPENINGS ARE: 5 Gauzed wrapped 8 Saw cut 11 None (open hole)
 1 Continuous slot 3 **Mill slot** 6 Wire wrapped 9 Drilled holes
 2 Louvered shutter 4 Key punched 7 Torch cut 10 Other (specify) _____

SCREEN-PERFORATED INTERVALS: From **10.5** ft. to **46** ft. From _____ ft. to _____ ft.
 From _____ ft. to _____ ft. From _____ ft. to _____ ft.
 SAND PACK INTERVALS: From **8.5** ft. to **46** ft. From _____ ft. to _____ ft.
 From _____ ft. to _____ ft. From _____ ft. to _____ ft.

6 GROUT MATERIAL: 1 Neat cement 2 **Cement grout** 3 **Bentonite** 4 Other _____

Grout Intervals From 3 **0** ft. to **6.5** Ft. From 2 **6.5** Ft. to **8.5** ft. From _____ ft. to _____ ft.

What is the nearest source of possible contamination:
 1 Septic tank 4 Lateral lines 7 Pit privy 10 Livestock pens 14 Abandoned water well
 2 Sewer lines 5 Cess pool 8 Sewage lagoon 11 Fuel storage 15 Oil well/ Gas well
 3 Watertight sewer lines 6 Seepage pit 9 Feedyard 12 Fertilizer storage 16 **Other (specify below) Contaminated Site**

Direction from well? _____ How many feet? _____

FROM	TO	CODE	LITHOLOGIC LOG	FROM	TO	PLUGGING INTERVALS
0	1		Concrete			
1	2		Silty Clay (CL)			
2	24		Silty Sandstone			
24	27		Gray Siltstone			
27	30.5		Sandstone- Brown			
30.5	34		Gray Siltstone			
34	42		Brown Sandstone			
42	46		Gray Siltstone			
46	TD		End of Borehole			

7 CONTRACTOR'S OR LANDOWNER'S CERTIFICATION: This water well was (x) constructed, (2) reconstructed, or (3) plugged under my jurisdiction and w
 Completed on (mo/day/yr) **05/19/04** And this record is true to the best of my knowledge and belief. Kansas
 Water Well Contractor's License No. **585** This Water Well Record was completed on (mo/day/yr) **05/25/04**
 under the business name of **Associated Environmental, Inc.** By (signature) **Darin R Duncan**


INSTRUCTIONS: Please fill in blanks and circle the correct answers. Send three copies to Kansas Department of Health and Environment, Bureau of Water, Topoka, Kansas 66620-0001. Telephone: 913-296-5545. Send one to WATER WELL OWNER and retain one for your records.

OFFICE USE ONLY

T

R

SEC

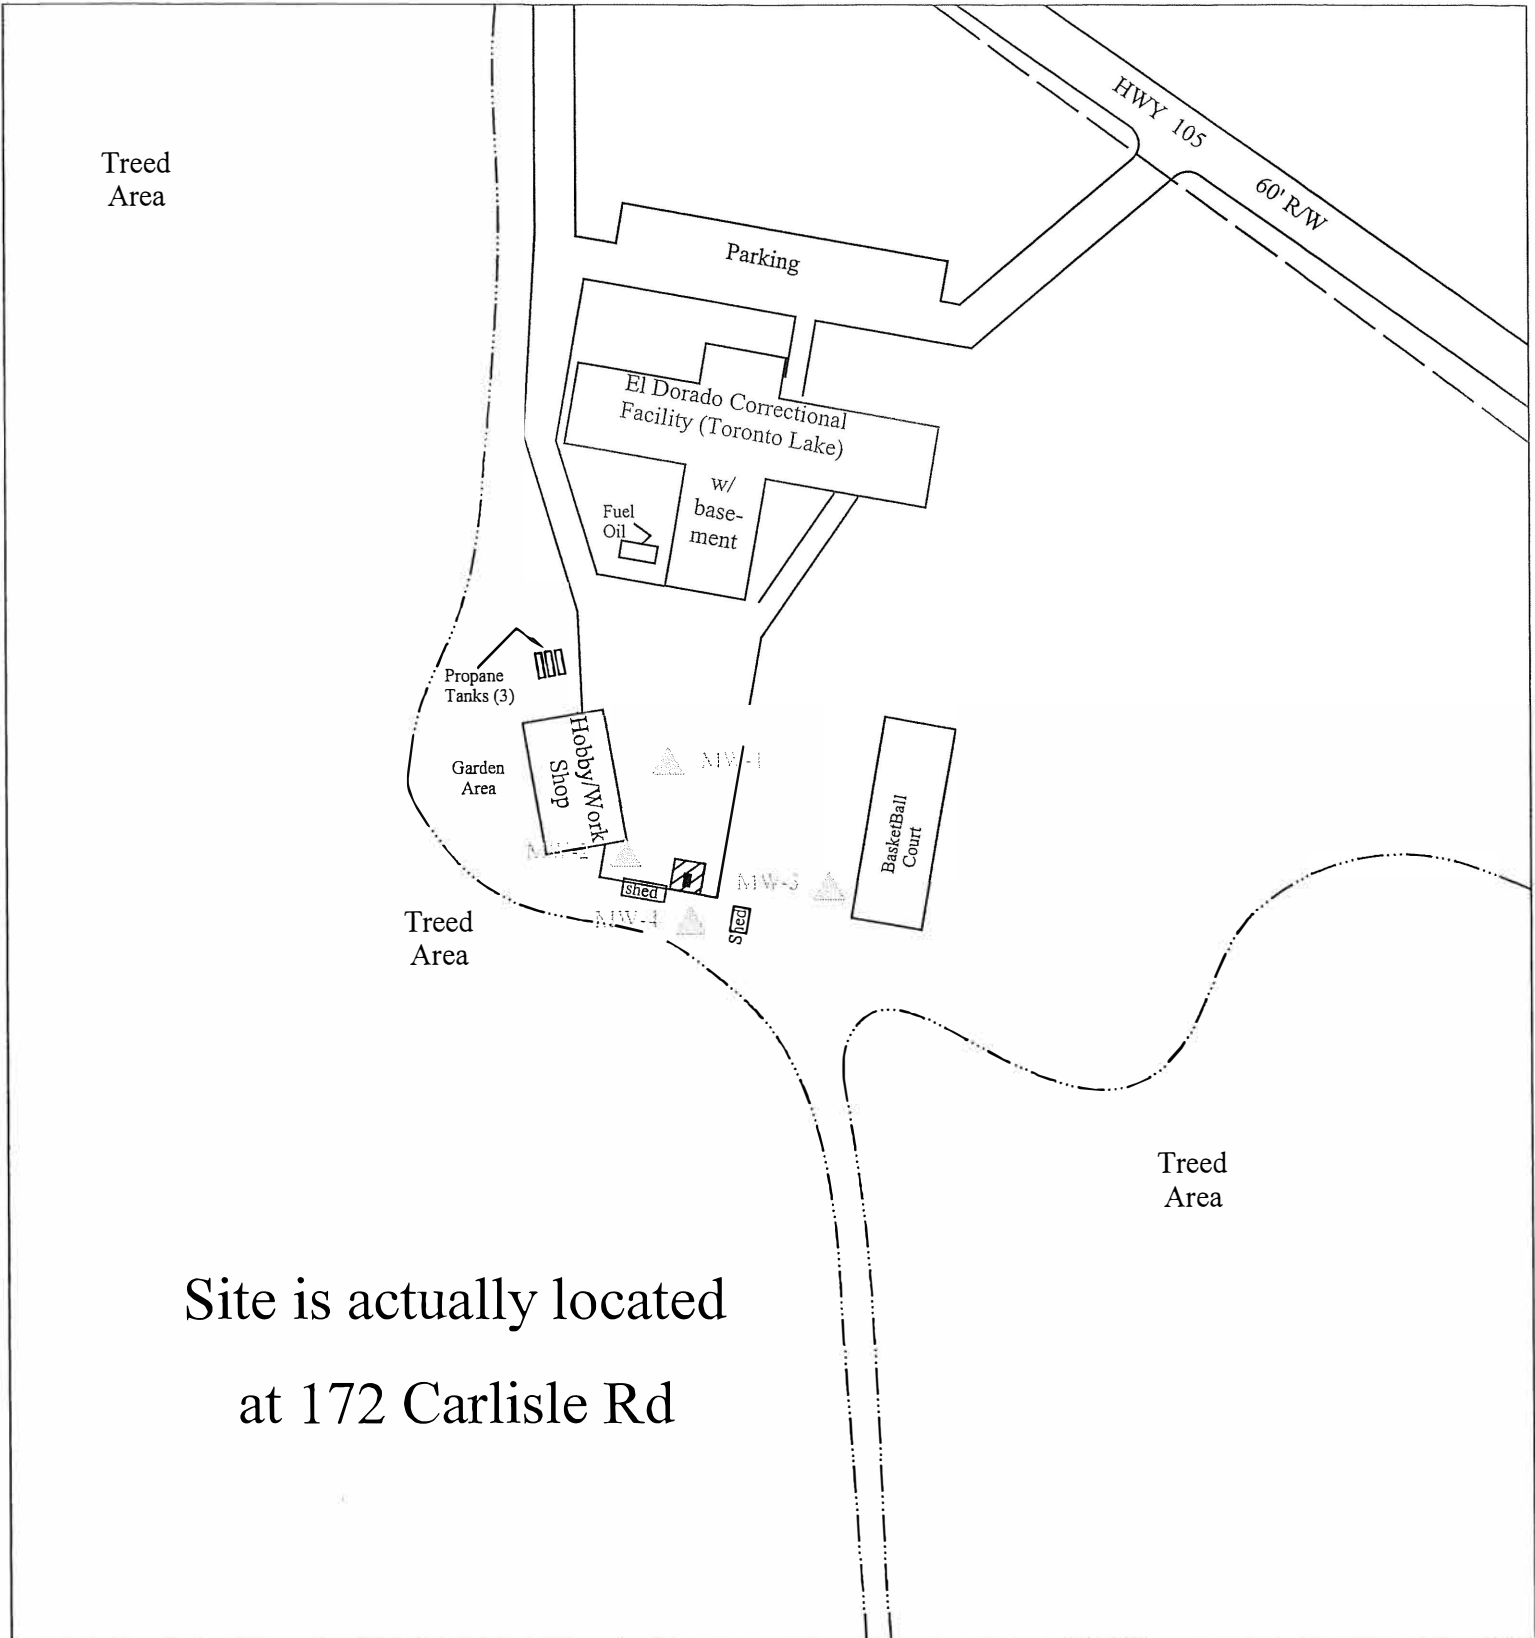

Site is actually located
at 172 Carlisle Rd

PROJECT: El Dorado Correctional Facility

ADDRESS: 172 HWY 105


LOCATION: Toronto, Kansas

DRAWN BY: MD **DATE:** 03/16/04

REVISED BY: B. STALNAKER **DATE:** 3/29/23

AEI JOB #: TF360 **KDHE JOB #:** U3-104-13290

SCALE: 1" = 100'

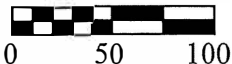

NOTES: Sample Date: 5/4/21

The former pump island and product line locations are unknown



**ASSOCIATED
ENVIRONMENTAL
INC.**

LEGEND:

- = Former UST basin; 2-500 gallon gasoline USTs
- = Current 500 gal gas AST
- = Boundary of treed area
- = Monitor Well location

= Site Boundary

