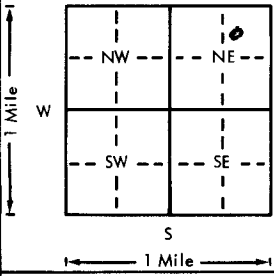
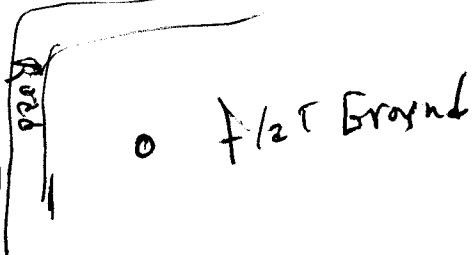


USE TYPEWRITER OR BALL
POINT PEN-PRESS FIRMLY,
PRINT CLEARLY.

WATER WELL RECORD
KSA 82a-1201-1215

Kansas Department of Health and
Environment-Division of Environment
(Water well Contractors)
Topeka, Kansas 66620

1. Location of well:	County Woodson	Fraction 5 1/2 NE 1/4 SE 1/4 NW 1/4	Section number 14	Township number T 26 S	Range number R 15 E
2. Distance and direction from nearest town or city: 10 Miles SE from Toronto, Kansas Street address of well location if in city:			3. Owner of well: Wayne M. Adrian R.R. or street: City, state, zip code: Toronto, Kansas		
4. Locate with "X" in section below: 		Sketch map: 		6. Bore hole dia. 8 in. Completion date 5/4/77 Well depth 100 ft.	
5. Type and color of material		From	To	7. <input checked="" type="checkbox"/> Cable tool <input type="checkbox"/> Rotary <input type="checkbox"/> Driven <input type="checkbox"/> Dug <input type="checkbox"/> Hollow rod <input type="checkbox"/> Jetted <input type="checkbox"/> Bored <input type="checkbox"/> Reverse rotary	
Soil		0	3	8. Use: <input checked="" type="checkbox"/> Domestic <input type="checkbox"/> Public supply <input type="checkbox"/> Industry <input checked="" type="checkbox"/> Irrigation <input type="checkbox"/> Air conditioning <input type="checkbox"/> Stock <input type="checkbox"/> Lawn <input type="checkbox"/> Oil field water <input type="checkbox"/> Other	
Clay		5	15	9. Casing: Material Jetset Height: Above or below Threaded <input type="checkbox"/> Welded <input type="checkbox"/> Surface 24 in. RMP <input type="checkbox"/> PVC <input type="checkbox"/> Weight 24 lbs./ft. Dia. 6 in. to 100 ft. depth Wall Thickness: inches or Dia. <input type="checkbox"/> in. to <input type="checkbox"/> ft. depth Gage No. <input type="checkbox"/>	
Lime		15	25	10. Screen: Manufacturer's name Jetset Type Jetset Dia. 6 Slot/gauze <input checked="" type="checkbox"/> Length 6 Set between 70 ft. and 100 ft. <input type="checkbox"/> ft. and <input type="checkbox"/> ft. Gravel pack? <input checked="" type="checkbox"/> Size range of material 1/2"	
Shale		25	65	11. Static water level: <input checked="" type="checkbox"/> mo./day/yr. <input type="checkbox"/> ft. below land surface Date <input type="checkbox"/>	
Lime		65	70	12. Pumping level below land surfaces: <input checked="" type="checkbox"/> ft. after <input type="checkbox"/> hrs. pumping <input type="checkbox"/> g.p.m. <input type="checkbox"/> ft. after <input type="checkbox"/> hrs. pumping <input type="checkbox"/> g.p.m. Estimated maximum yield <input type="checkbox"/> g.p.m.	
Lime S. Pt		70	100	13. Water sample submitted: <input type="checkbox"/> mo./day/yr. <input type="checkbox"/> Yes <input checked="" type="checkbox"/> No Date <input type="checkbox"/>	
				14. Well head completion: <input type="checkbox"/> Pitless adapter <input type="checkbox"/> inches above grade	
				15. Well grouted? <input type="checkbox"/> With: <input type="checkbox"/> Neat cement <input type="checkbox"/> Bentonite <input checked="" type="checkbox"/> Concrete Depth: From 0 ft. to 10 ft.	
				16. Nearest source of possible contamination: None ft. <input type="checkbox"/> Direction <input type="checkbox"/> Type <input type="checkbox"/> Well disinfected upon completion? <input checked="" type="checkbox"/> Yes <input type="checkbox"/> No	
				17. Pump: <input checked="" type="checkbox"/> Not installed Manufacturer's name <input type="checkbox"/> Model number <input type="checkbox"/> HP <input type="checkbox"/> Volts <input type="checkbox"/> Length of drop pipe <input type="checkbox"/> ft. capacity <input type="checkbox"/> g.p.m. Type: <input type="checkbox"/> Submersible <input type="checkbox"/> Turbine <input type="checkbox"/> Jet <input type="checkbox"/> Reciprocating <input type="checkbox"/> Centrifugal <input type="checkbox"/> Other	
				18. Water well contractor's certification: This well was drilled under my jurisdiction and this report is true to the best of my knowledge and belief. Eureka Well Service 296 Business name Eureka, Kans License No. <input type="checkbox"/> Address Eureka, Kans Signed Lawrence Date <input checked="" type="checkbox"/> Authorized representative	
18. Elevation:		19. Remarks:			
Topography: <input type="checkbox"/> Hill <input type="checkbox"/> Slope <input checked="" type="checkbox"/> Upland <input checked="" type="checkbox"/> Valley					

Forward the white, blue and pink copies to the Department of Health and Environment

Form WWC-5