


1 LOCATION OF WATER WELL: Fraction NC 1/4 SE 1/4 SE 1/4 Section Number 04 Township Number T 26 S Range Number R 15 EW

Distance and direction from nearest town or city street address of well if located within city?
5/8 South 1 mile West 4m R. N.A.

2 WATER WELL OWNER: RR# St. Address, Box # : RR # 175-A Board of Agriculture, Division of Water Resources
 City, State, ZIP Code : VATES CENTER KANSAS Application Number:

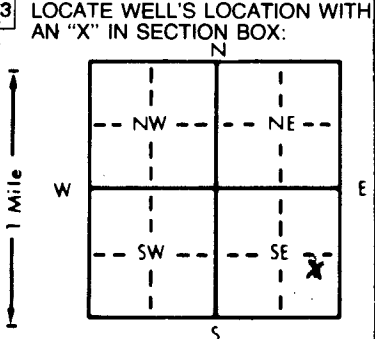

4 DEPTH OF COMPLETED WELL 80 ft. ELEVATION:
 Depth(s) Groundwater Encountered 1. 30 ft. 2. . ft. 3. . ft.
 WELL'S STATIC WATER LEVEL 20 ft. below land surface measured on mo/day/yr 9-27-94
 Pump test data: Well water was Boiler Test after . . . hours pumping . . . gpm
 Est. Yield 20 gpm: Well water was . . . ft. after . . . hours pumping . . . gpm
 Bore Hole Diameter. 8 1/4 in. to 80 ft., and . . . in. to . . . ft.
 WELL WATER TO BE USED AS: 5 Public water supply 8 Air conditioning 11 Injection well
 1 Domestic 3 Feedlot 6 Oil field water supply 9 Dewatering 12 Other (Specify below)
 2 Irrigation 4 Industrial 7 Lawn and garden only 10 Monitoring well
 Was a chemical/bacteriological sample submitted to Department? Yes . . . No ; If yes, mo/day/yr sample was submitted
 Water Well Disinfected? Yes No

5 TYPE OF BLANK CASING USED: 1 Steel 3 RMP (SR) 5 Wrought iron 8 Concrete tile CASING JOINTS: Glued Clamped . . .
 2 PVC 4 ABS 6 Asbestos-Cement 9 Other (specify below) Welded . . .
 Blank casing diameter 5 in. to 80 ft., Dia. . . in. to . . . ft., Dia. . . in. to . . . ft.
 Casing height above land surface. 12 in., weight SCH 26 lbs./ft. Wall thickness or gauge No. 160
 TYPE OF SCREEN OR PERFORATION MATERIAL: 7 Fiberglass 10 Asbestos-cement
 1 Steel 3 Stainless steel 8 RMP (SR) 11 Other (specify) . . .
 2 Brass 4 Galvanized steel 6 Concrete tile 9 ABS 12 None used (open hole)
 SCREEN OR PERFORATION OPENINGS ARE: 5 Gauzed wrapped 8 Saw cut 36 ft 11 None (open hole)
 1 Continuous slot 20 ft 3 Mill slot 6 Wire wrapped 9 Drilled holes
 2 Louvered shutter 4 Key punched 7 Torch cut 10 Other (specify) . . .
 SCREEN-PERFORATED INTERVALS: From 80 ft. to 56 ft., From . . . ft. to . . . ft.
 From . . . ft. to . . . ft., From . . . ft. to . . . ft.
 GRAVEL PACK INTERVALS: From 80 ft. to 58 ft., From . . . ft. to . . . ft.
 From . . . ft. to . . . ft., From . . . ft. to . . . ft.

6 GROUT MATERIAL: 1 Neat cement 2 Cement grout 3 Bentonite 4 Other . . .
 Grout Intervals: From 0 ft. to 21 ft., From . . . ft. to . . . ft., From . . . ft. to . . . ft.
 What is the nearest source of possible contamination: 1 Septic tank 4 Lateral lines 7 Pit privy 10 Livestock pens 14 Abandoned water well
 2 Sewer lines 5 Cess pool 8 Sewage lagoon 11 Fuel storage 15 Oil well/Gas well
 3 Watertight sewer lines 6 Seepage pit 9 Feedyard 12 Fertilizer storage 16 Other (specify below)
 13 Insecticide storage
 Direction from well? N.W. How many feet? 135

FROM		TO	LITHOLOGIC LOG	FROM	TO	PLUGGING INTERVALS
0	5		SOIL	0	5	
5	10		red clay	5	17	
10	22		ROCK	17	22	
22	25		sandy rock	22	25	
25	40		SHALE & STY	25	40	
40	48		DARK SHALE	40	48	
48	52		lime	48	52	
52	63		SHALE	52	63	
63	68		WHITE SAND	63	68	
68	80		Blue SHALE	68	80	

7 CONTRACTOR'S OR LANDOWNER'S CERTIFICATION: This water well was (1) constructed, (2) reconstructed, or (3) plugged under my jurisdiction and was completed on (mo/day/year) 9-26-94 and this record is true to the best of my knowledge and belief. Kansas Water Well Contractor's License No. 52512 This Water Well Record was completed on (mo/day/yr) 10-6-94 under the business name of JEFFREY by (signature) Jack B. Jeffrey

INSTRUCTIONS: Use typewriter or ball point pen. PLEASE PRESS FIRMLY and PRINT clearly. Please fill in blanks, underline or circle the correct answers. Send top three copies to Kansas Department of Health and Environment, Bureau of Water, Topeka, Kansas 66620-0001. Telephone: 913-296-5545. Send one to WATER WELL OWNER and retain one for your records.

OFFICE USE ONLY T R E W SEC. 1/4 1/4 1/4